
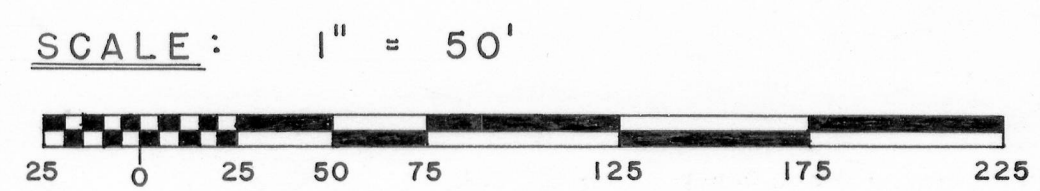
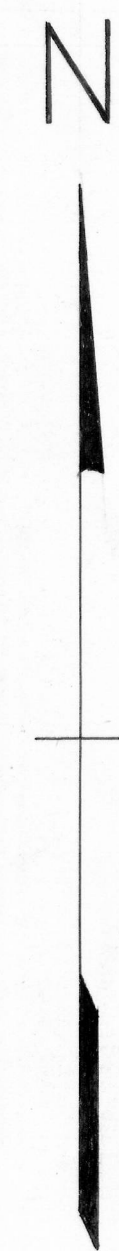


A COPY IS IN
BIG CITY FILE


LANCASTER STATE BANK SURVEY

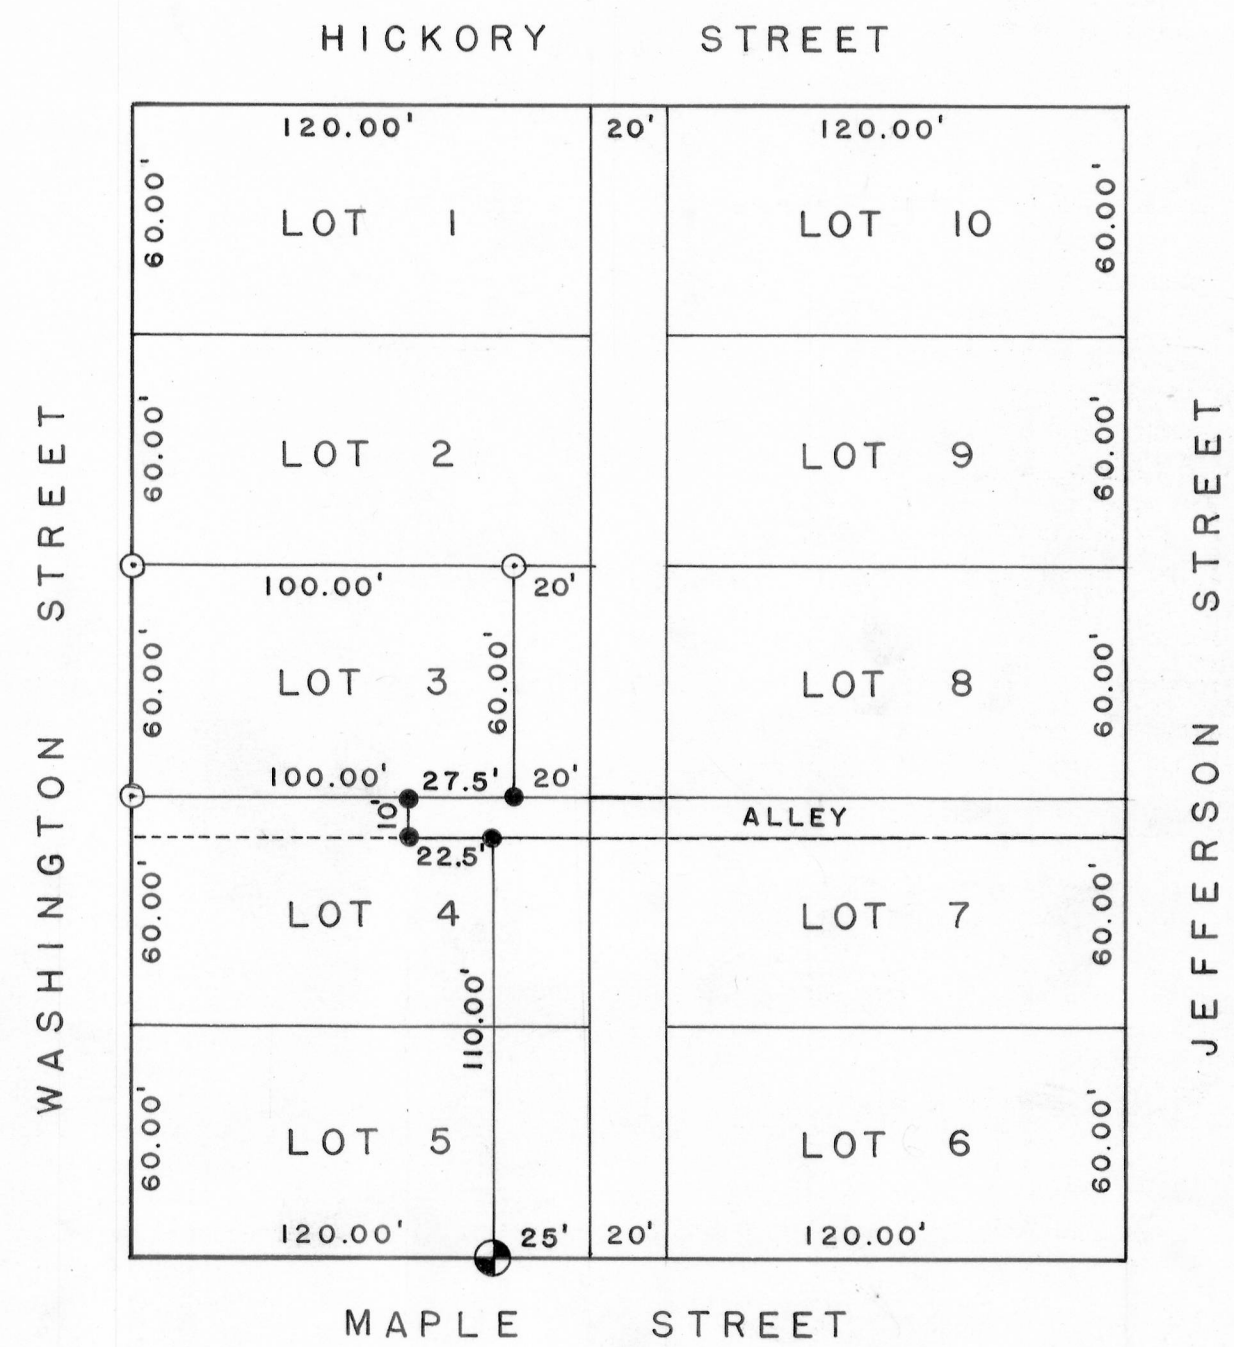

- LEGEND:**
- ⊙ 1" X 24" IRON PIPE PLACED BY THIS SURVEY
 - P.K. NAIL PLACED BY THIS SURVEY
 - ⊕ CHISEL MARK MADE BY THIS SURVEY

DESCRIPTION:

The West 100.00 feet of Lot (3) in Block (10) of the Original Plat of the Village (now City) of Lancaster, Grant County, Wisconsin, according to the recorded map or plat thereof. Also Begin at the Southwest corner of said Block 10; thence North 120 feet; thence East 72.5 feet; thence South 10 feet; thence East 22.5 feet; thence South 110 feet; thence West 95 feet to the place of beginning.

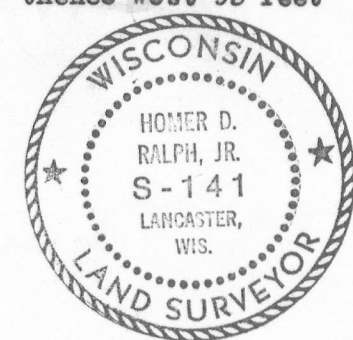

BLOCK 10, O.P.
LANCASTER, WIS.

David K. Krohn
DAVID K. KROHN
4 / 17 / 74 - 4 / 18 / 74

Homer D. Ralph, Jr.
HOMER D. RALPH, JR.
SURVEYOR FOR GRANT
COUNTY, WISCONSIN.