



WISCONSIN FEEDER PIG MARKETING CO-OP SURVEY

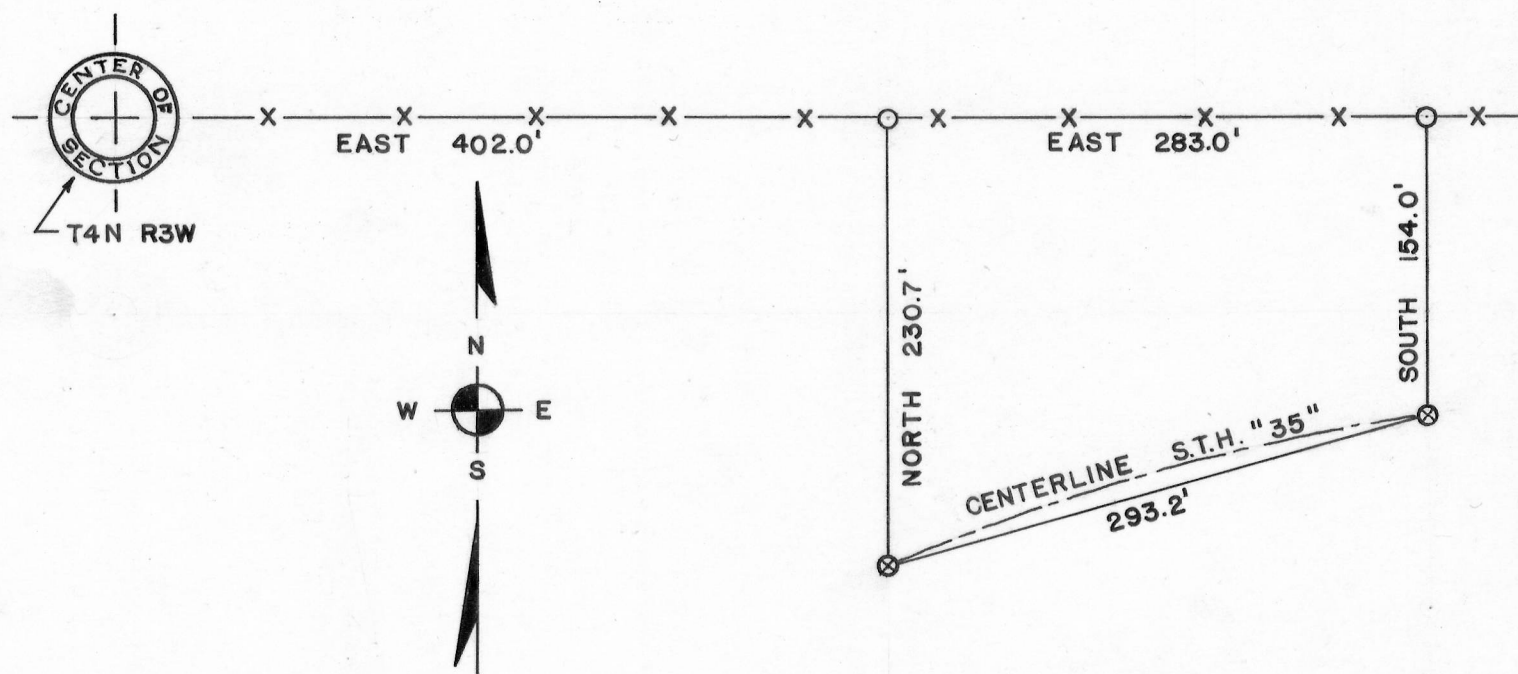

○ 1" X 24" IRON PIPE PLACED BY THIS SURVEY.

⊗ TACK PLACED IN CENTERLINE OF S.T.H. "35"

—X—X—X— EXISTING FENCE LINE

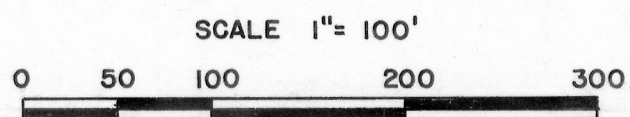

DESCRIPTION:

COMMENCING AT THE CENTER OF SECTION 8, T4N, R3W, OF THE 4TH P.M., GRANT CO., WIS., THENCE 402.0 FEET EAST TO THE POINT OF BEGINNING; THENCE EAST 283.0 FEET; THENCE SOUTH 154.0 FEET TO A POINT ON THE CENTERLINE OF S.T.H. "35"; THENCE SOUTHWESTERLY ALONG THE CHORD OF A CURVE HAVING A RADIUS OF 2865.0 FEET FOR 293.2 FEET, THENCE NORTH 230.7 FEET TO THE POINT OF BEGINNING, CONTAINING 1.2 ACRES MORE OR LESS.

Garth A. Larson
GARTH A. LARSON
4/10/69

Homer D. Ralph, Jr.
HOMER D. RALPH, JR.
SURVEYOR FOR GRANT CO., WIS.
WIS. REG. NO. S-141

