


MURRAY — MITCHELL SURVEY

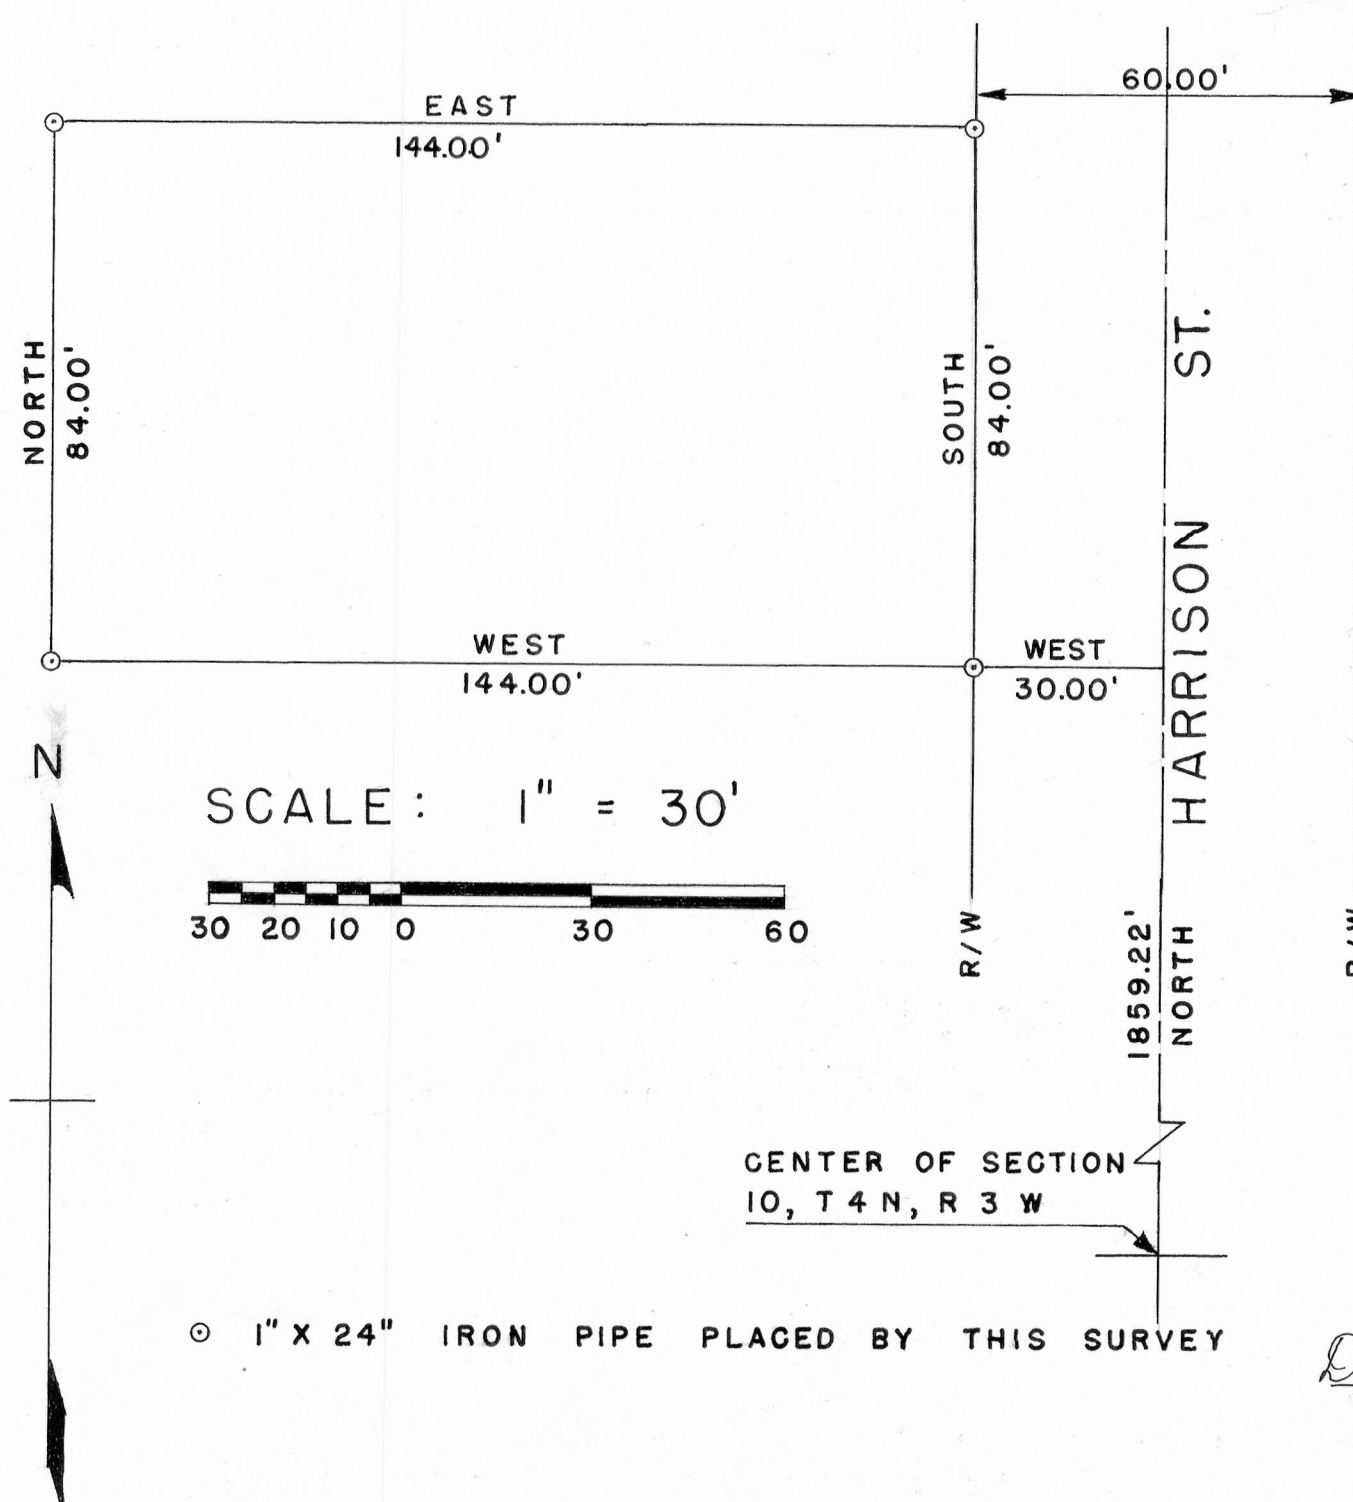

DESCRIPTION:

Begin at a point which is 1859.22 feet North and 30.00 feet West of the center of Section 10, T 4 N, R 3 W, of the 4th P.M., Grant County, Wisconsin; thence West 144.00 feet; thence North 84.00 feet; thence East 144.00 feet; thence South 84.00 feet to the place of beginning. Being part of Block 82 of the Assessor's Plat of the City of Lancaster.

The measured distance between the center of Section 10 and the North Quarter corner of Section 10 is 2657.07 feet.



David K. Krohn
DAVID K. KROHN
8/17/73 - 8/20/73

Homer D. Ralph, Jr.
HOMER D. RALPH, JR.
SURVEYOR FOR GRANT
COUNTY, WISCONSIN