


HABERLIE SURVEY

SCALE 1" = 40'

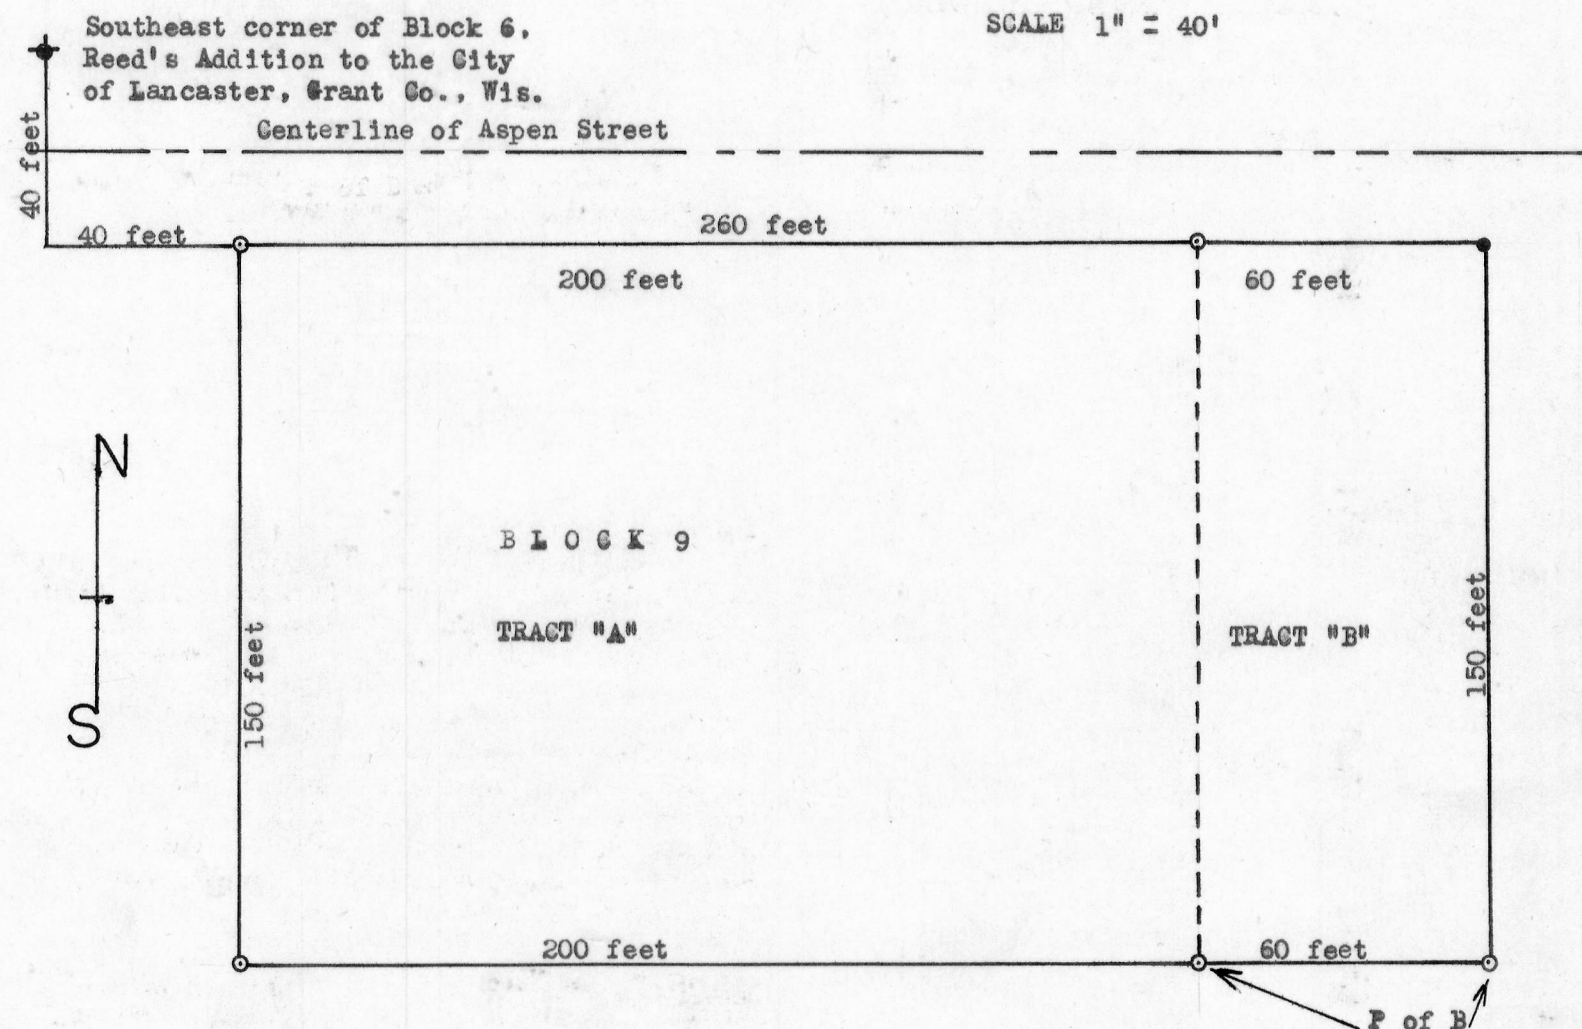


○ - 1" X 24" iron pipe placed by this survey

● - hole in side walk

✦ - iron pipe found by this survey

Charles Lange
Charles Lange
6/23-7/12/72

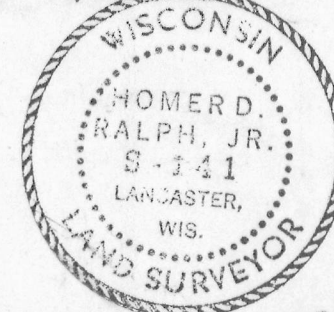

Homer D. Ralph, Jr.
Homer D. Ralph Jr.
Surveyor for Grant
County, Wisconsin.

DESCRIPTION ACCORDING TO ASSESSMENT PLAT (entire tract)

Block 9, Reed's Add. City of Lancaster, Grant County, Wisconsin.

DESCRIPTION OF TRACT "A"

Begin at a point which is 496 feet South and 410 feet West of the North Quarter corner of Section 10, T 4 N, R 3 W. of the 4th P.M., Grant County, Wisconsin; thence West 200 feet; thence North 150 feet; thence East 200 feet; thence South 150 feet to the place of beginning.

DESCRIPTION OF TRACT "B"

Begin at a point which is 496 feet South and 350 feet West of the North Quarter corner of Section 10, T 4 N, R 3 W. of the 4th P.M., Grant County, Wisconsin; thence West 60 feet; thence North 150 feet; thence East 60 feet; thence South 150 feet to the place of beginning.