


1-40

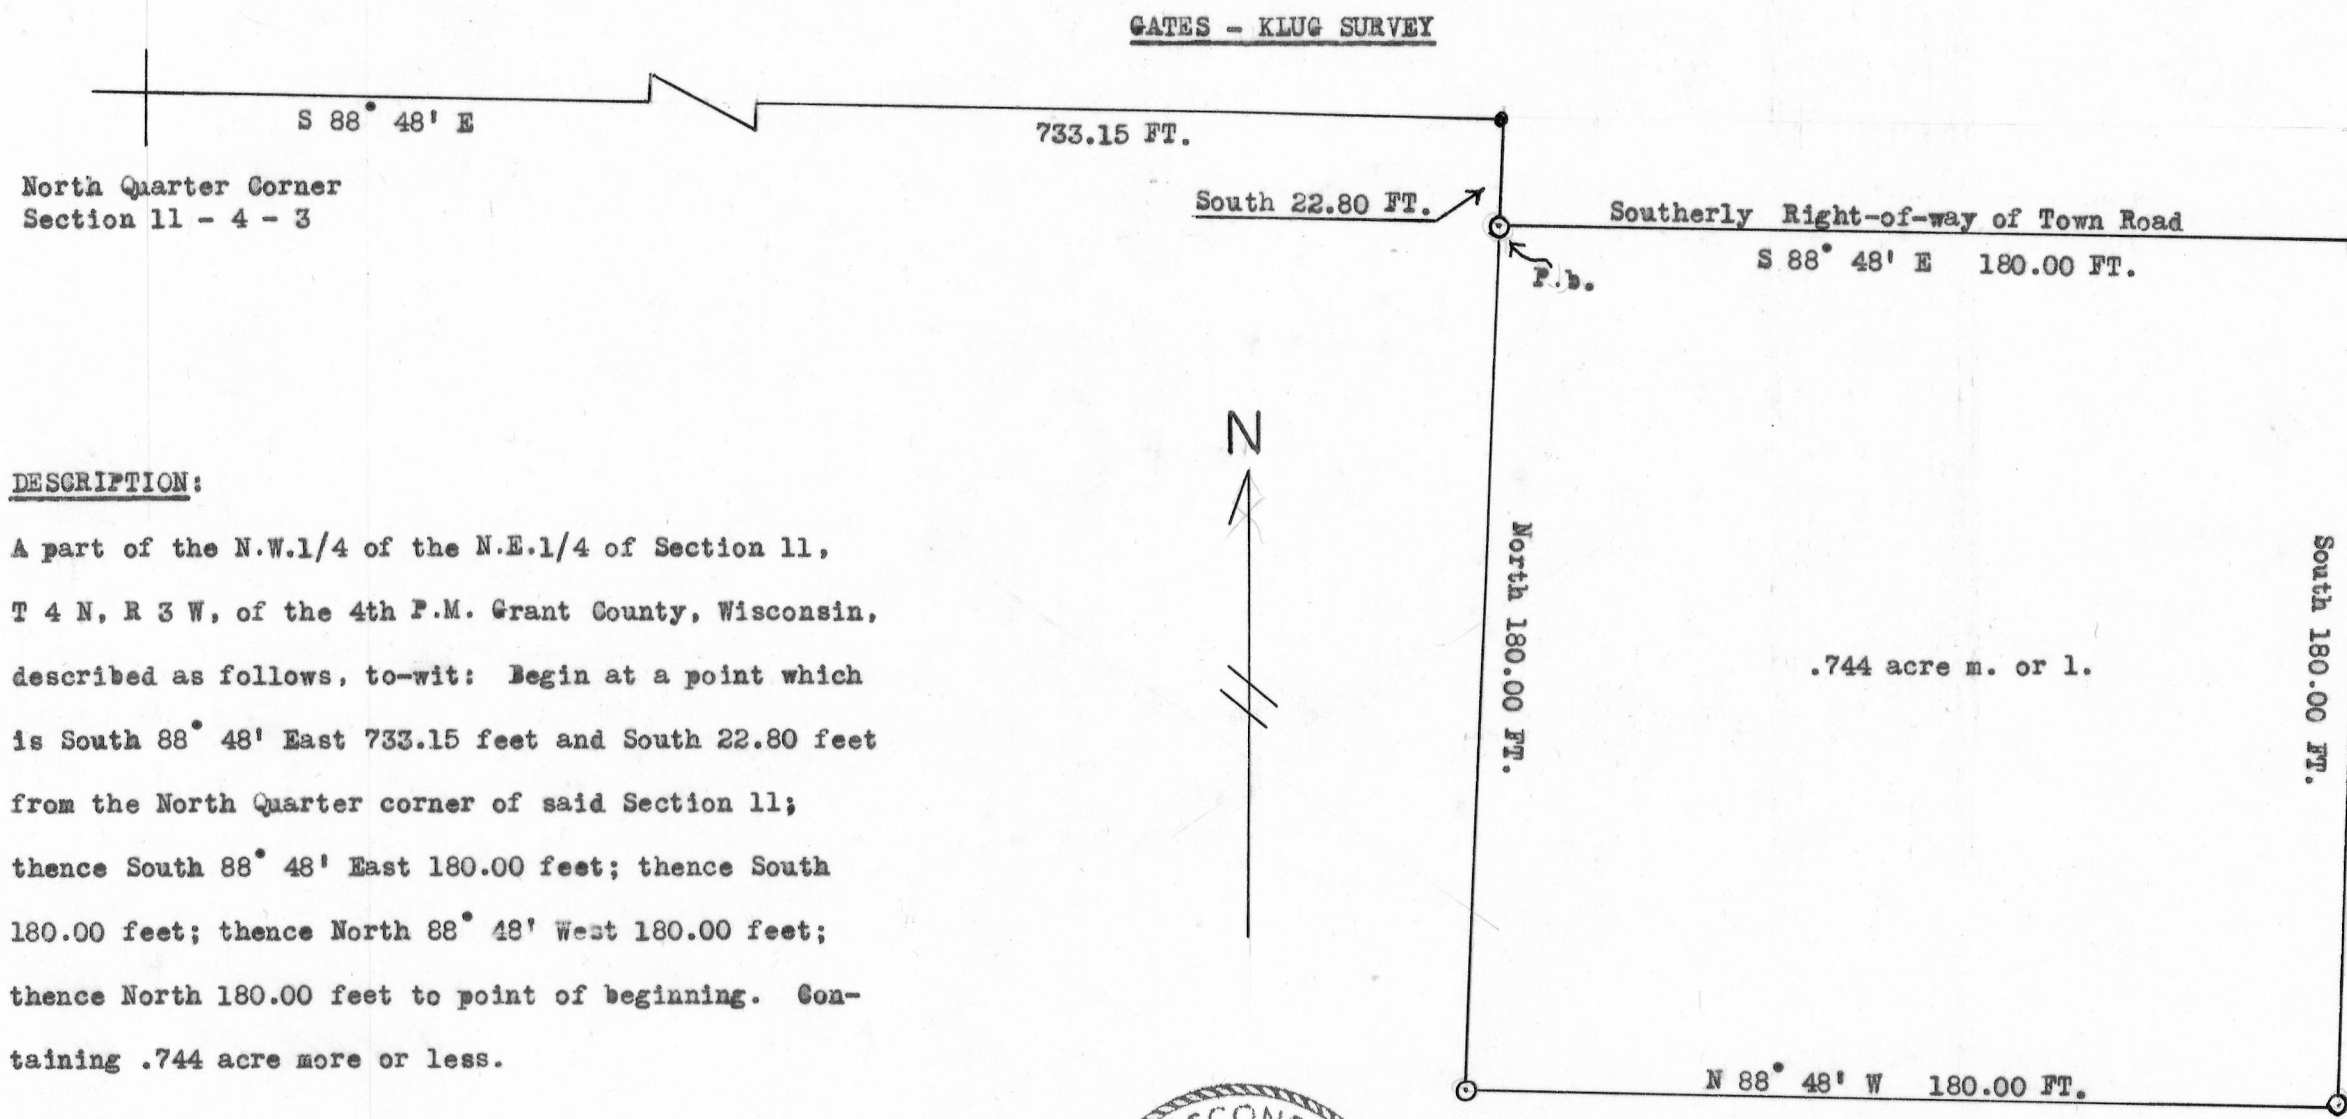

DESCRIPTION:

A part of the N.W.1/4 of the N.E.1/4 of Section 11,
T 4 N, R 3 W, of the 4th P.M. Grant County, Wisconsin,
described as follows, to-wit: Begin at a point which
is South 88° 48' East 733.15 feet and South 22.80 feet
from the North Quarter corner of said Section 11;
thence South 88° 48' East 180.00 feet; thence South
180.00 feet; thence North 88° 48' West 180.00 feet;
thence North 180.00 feet to point of beginning. Con-
taining .744 acre more or less.

Homer D. Ralph, Jr.
Homer D. Ralph, Jr.
Surveyor for Grant
County, Wisconsin



Charles Lange
Charles Lange
3/30 - 4/6/71

SCALE: 1" = 40'

- 1" X 24" IRON PIPE PLACED BY THIS SURVEY
- P.K. NAIL IN PAVEMENT PLACED BY THIS SURVEY