


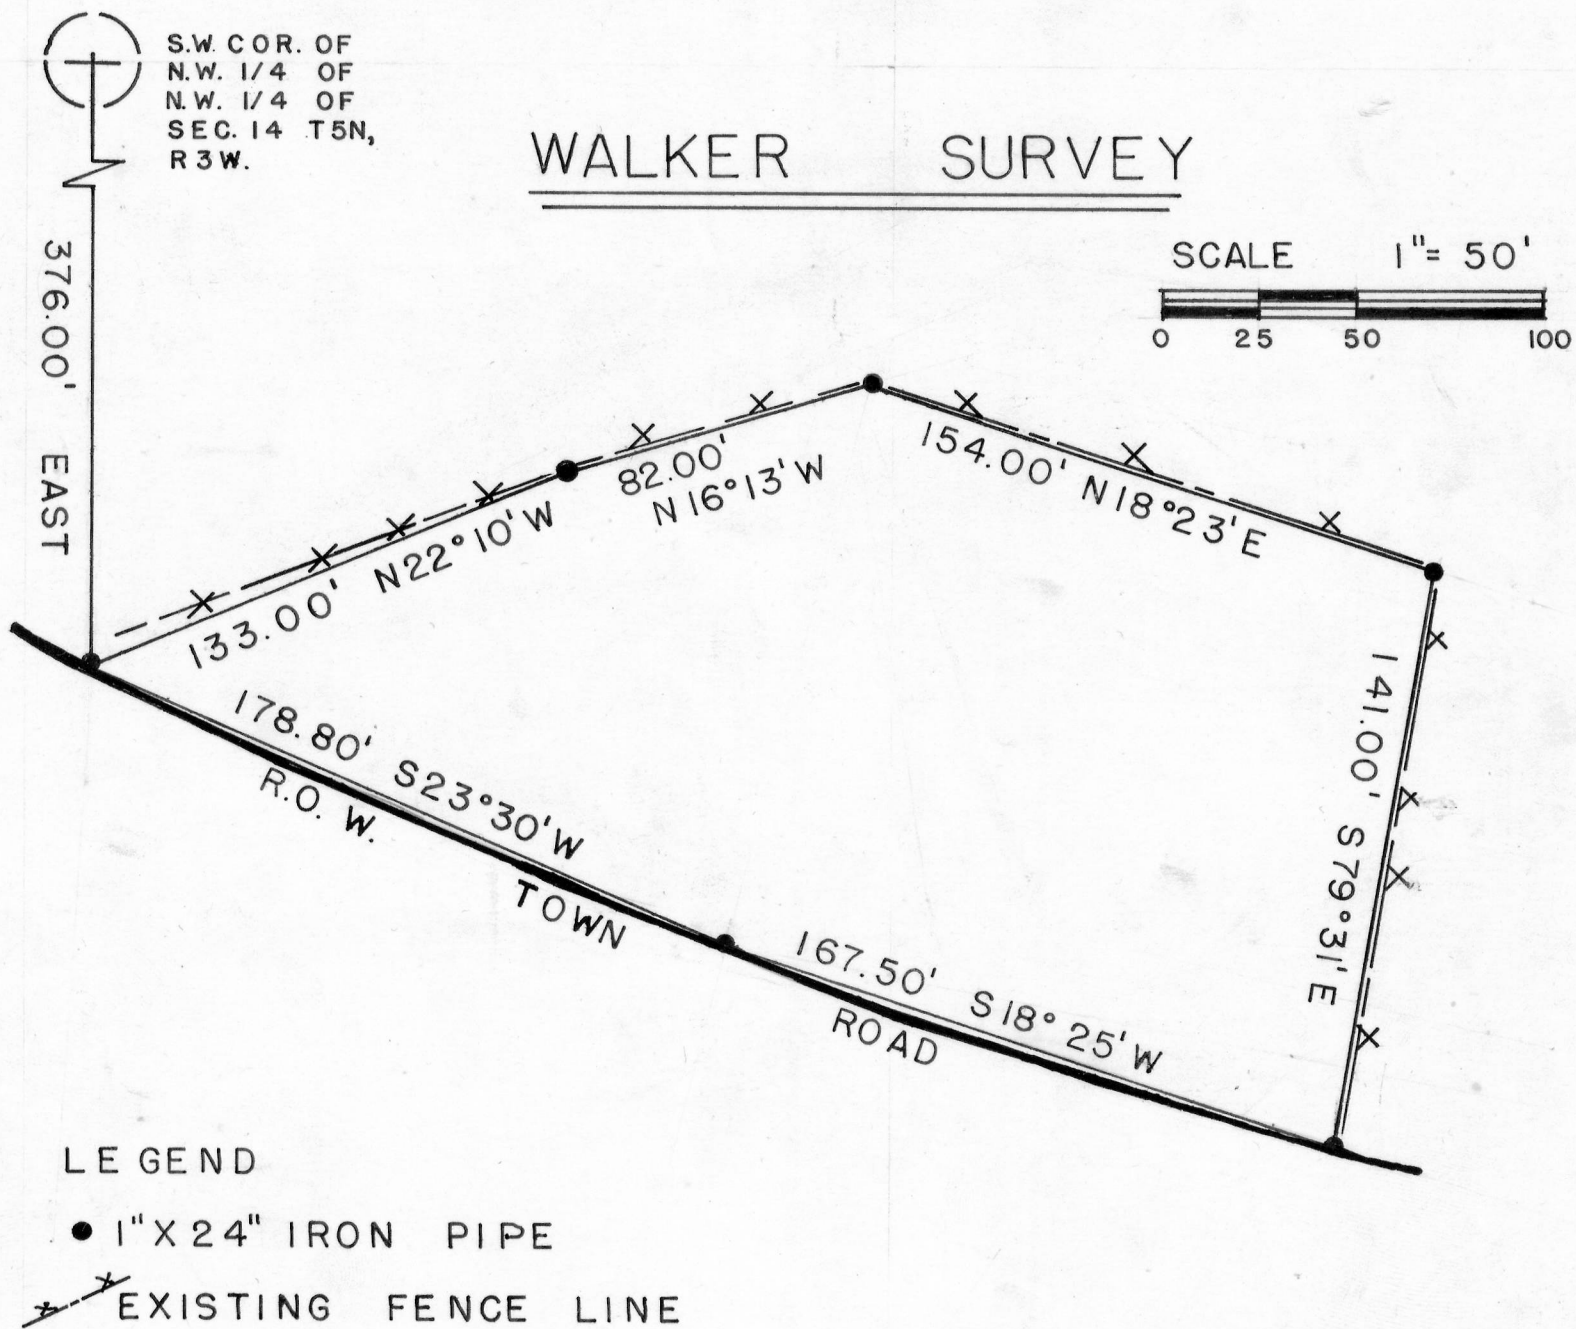

Description:

Part of the N.W.1/4 of N.W.1/4 of Section 14, T5N, R3W, of the 4th P.M., Grant County, Wisconsin.

Described as follows to-wit: Beginning at a point on the Easterly Rt. of Way of the Town Road which is 376.00 feet East of the Southwest corner of said N.W. 1/4 of N.W. 1/4; thence N22°10'W 133.00 feet; thence N16°13'W 82.00 feet; thence N18°23'E 154.00 feet; thence S79°31'E 141.00 feet to a point upon the easterly Rt. of Way of said Town Road; thence S18°25'W 167.50 feet along a chord of the curve of said Town Road; thence S23°30'W 178.80 feet along a chord of the curve of said Town Road to the point of beginning. Said tract of land containing 1.0 acres more or less.



Art Seymour
Art Seymour 10/4/69-
10/17/69

Homer D. Ralph, Jr.
Homer D. Ralph Jr.
Surveyor for Grant County