


TURNER MOTORS SURVEY

DESCRIPTION:

Part of the S.E.1/4 of the S.E.1/4 of Section 34, T 5 N, R 3 W, of the 4th P.M., Grant County, Wisconsin, described as follows to-wit: Begin at the Southwest Corner of the S.E.1/4 of the S.E.1/4 of said Section 34; thence South 88° 16' 40" East 258.50 feet; thence North 60° 34' West 65.30 feet; thence South 88° 16' 40" East 270.95 feet; thence North 06° 43' 20" East 250.70 feet; thence East 82.00 feet; thence North 196.72 feet to the point of beginning;

thence North 58° 17' West 45.53 feet; thence South 31° 43' West 180.00 feet; thence North 58° 17' West 131.07 feet to a point on the Easterly right-of-way of U.S. Hwy. #61; thence North 31° 43' East 345.30 feet along said Easterly right-of-way; thence North 34° 05' East 113.00 feet along the chord of a curve of said right-of-way concave Southeasterly having a radius of 1372.50 feet; thence South 327.15 feet to the point of beginning. Containing 1.11 acres more or less.

SCALE: 1" = 100'

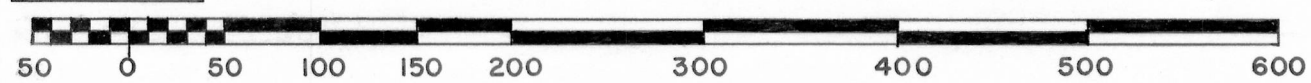

LEGEND:

- 1" X 24" IRON PIPE PLACED BY THIS SURVEY
- 1" X 24" IRON PIPE PLACED BY PREVIOUS SURVEY
- CENTERLINE



Homer D. Ralph, Jr.
HOMER D. RALPH, JR.
SURVEYOR FOR GRANT
COUNTY, WISCONSIN.

David K. Krohn
DAVID K. KROHN
4/18/74 - 5/3/74

