


LANC. INDUSTRIAL DEVELOPMENT-SURVEY

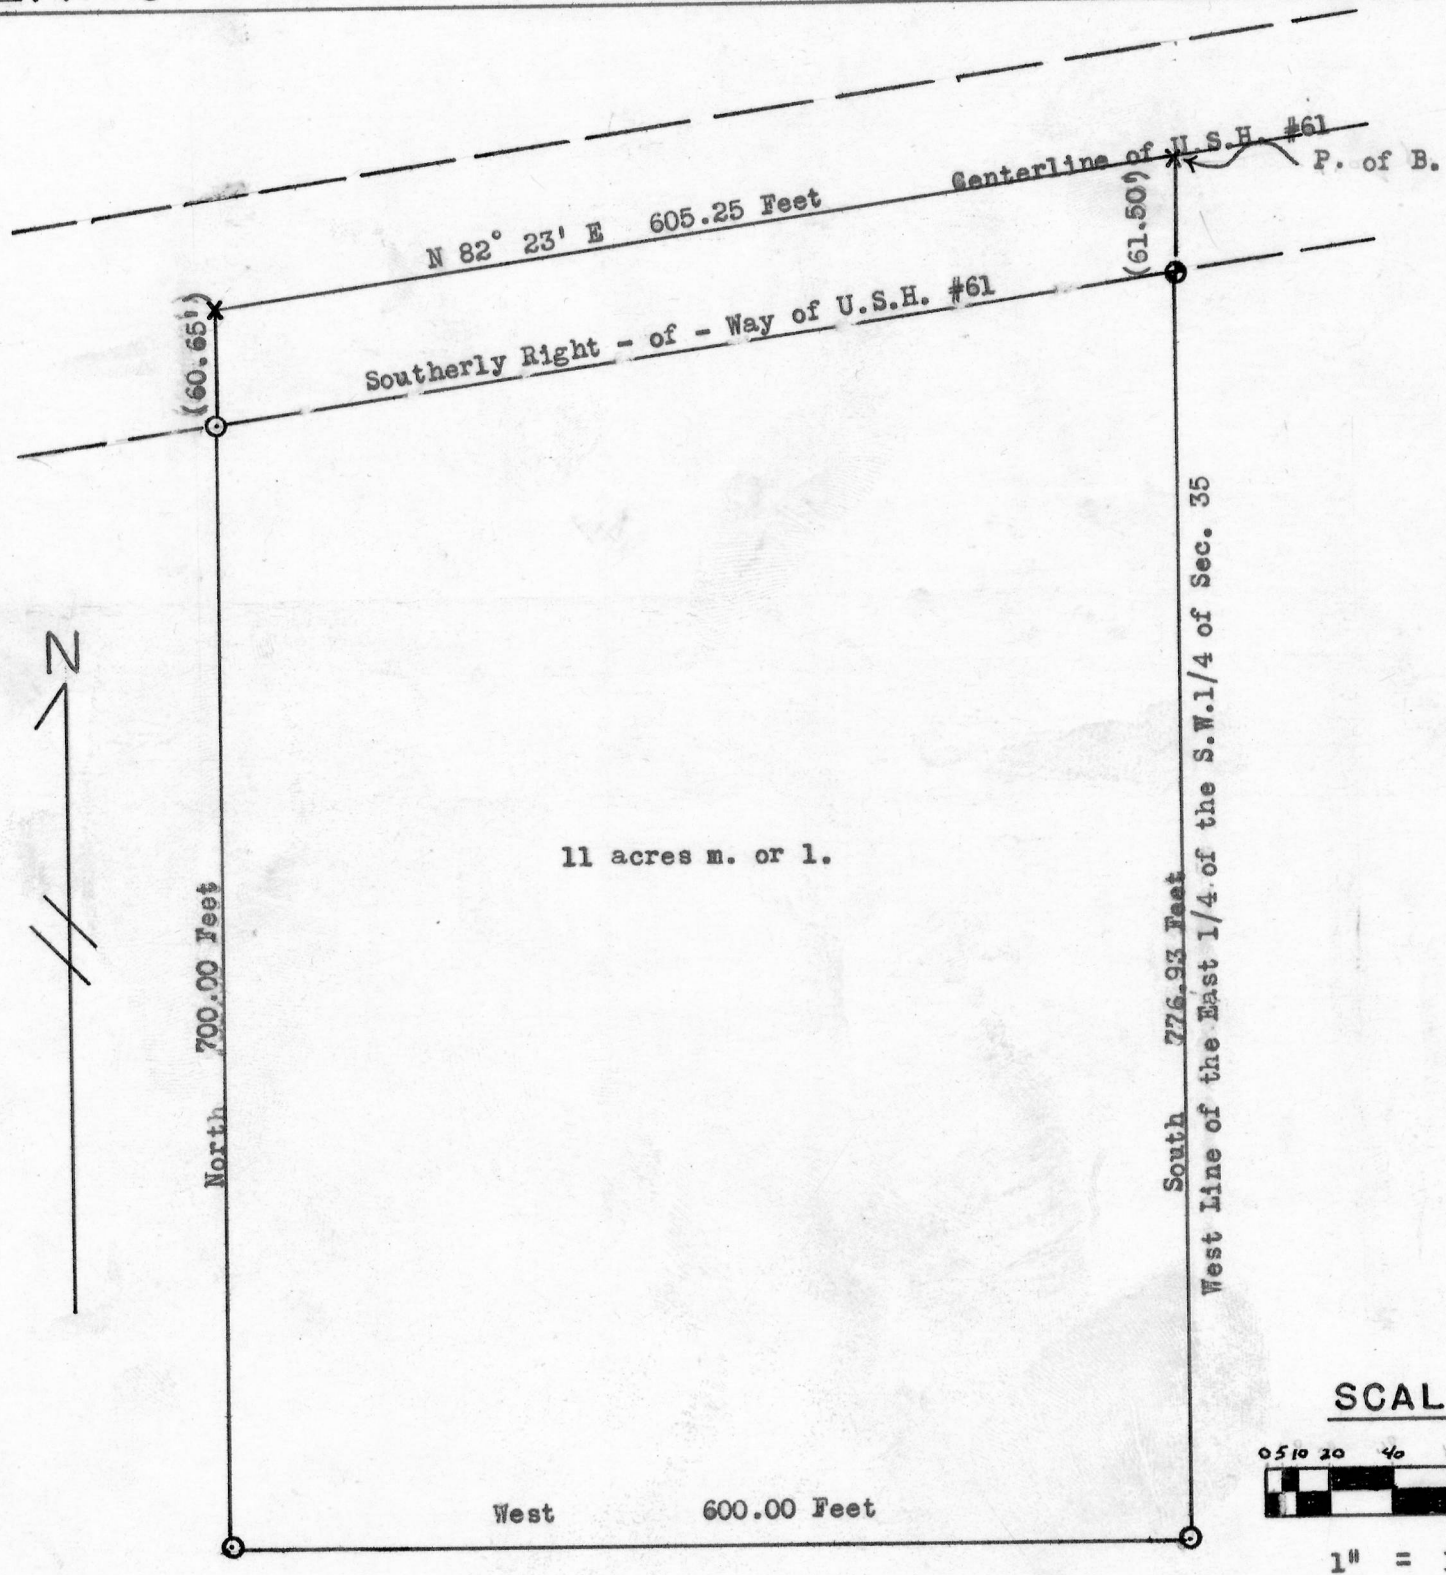

LEGEND:

- 1" X 24" IRON PIPE PLACED BY THIS SURVEY
- EXISTING CEMENT FILLED FENCE POST
- x RAILROAD SPIKE IN CENTERLINE

Charles Lange
Charles Lange
6/18/71-6/21/71

Homer D. Ralph, Jr.
Homer D. Ralph, Jr.
Surveyor for Grant
County, Wisconsin



DESCRIPTION:

A part of the East 1/2 of the S.W.1/4 of Section 35, T 5 N, R 3 W. of the 4th P.M., Grant County, Wisconsin, described as follows to-wit: Begin at a point on the West line of the East 1/4 of S.W.1/4 of said Section 35, where same intersects with the centerline of U.S. Highway 61; thence South 838.43 feet; thence West 600.00 feet; thence North 760.65 feet to said centerline; thence North 82° 23' East 605.25 feet along said centerline to the place of beginning. Containing 11.0 acres more or less.