


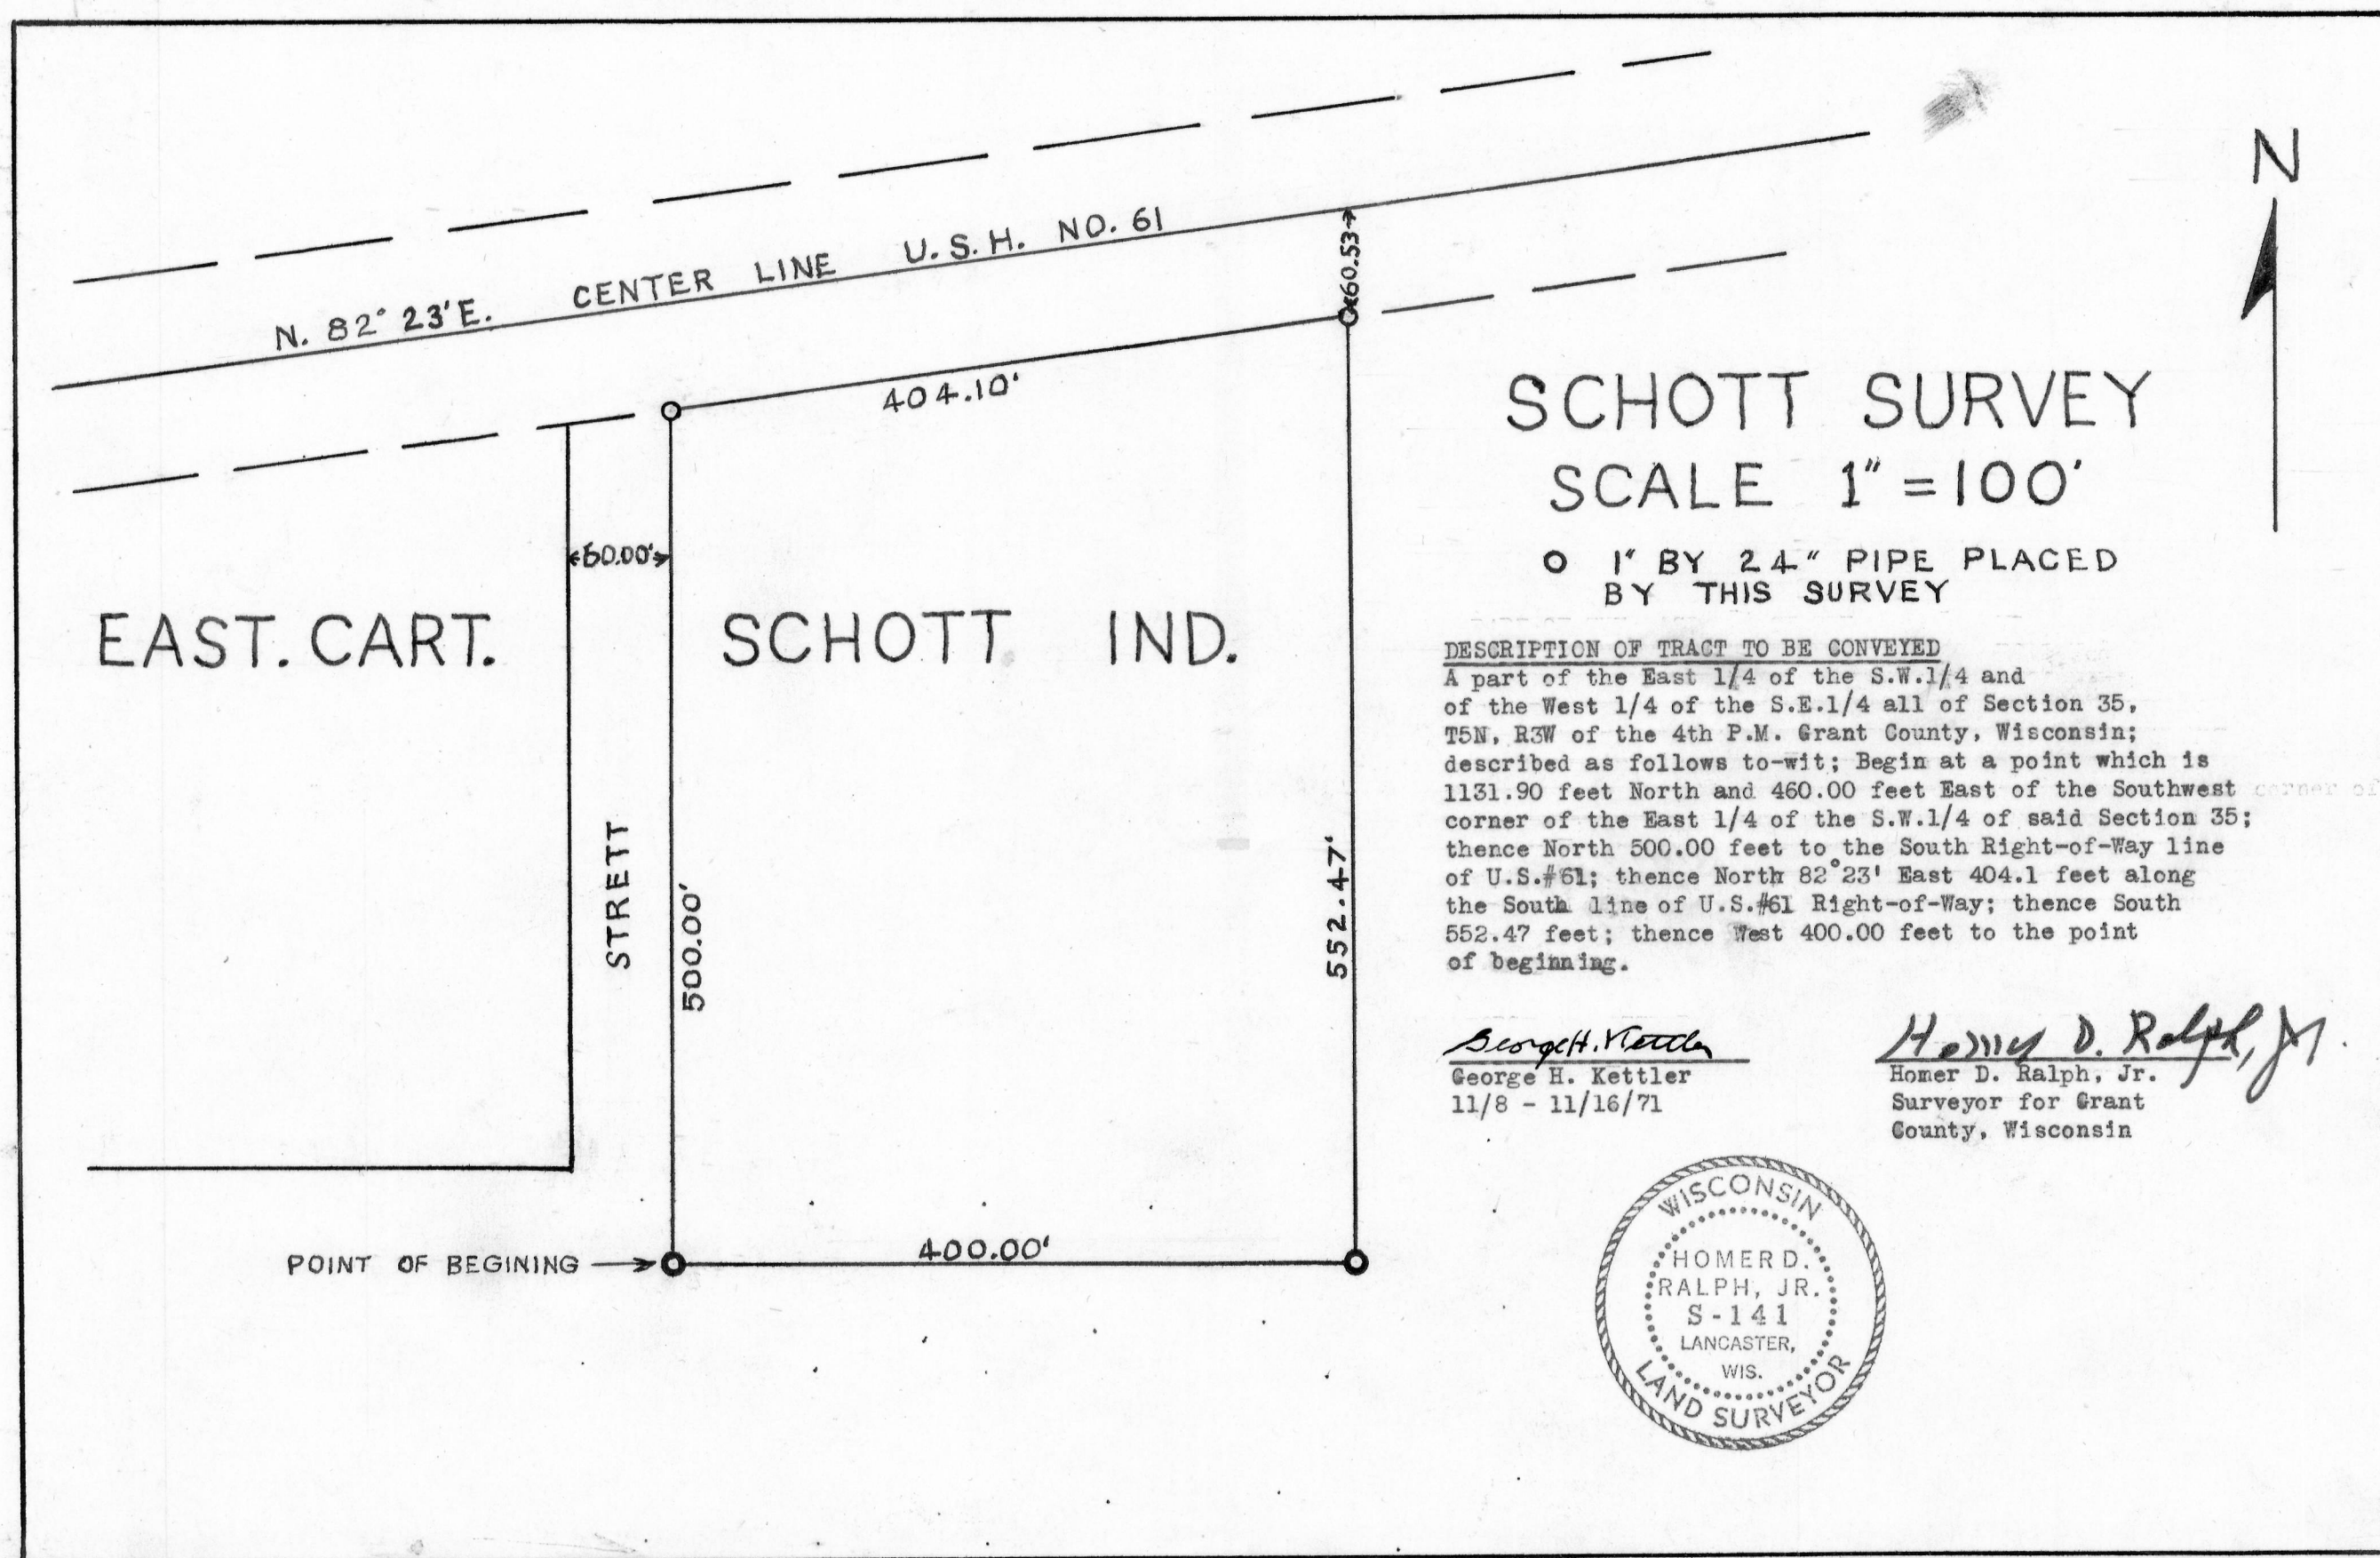

SCHOTT SURVEY
SCALE 1" = 100'

○ 1" BY 2.4" PIPE PLACED
BY THIS SURVEY

DESCRIPTION OF TRACT TO BE CONVEYED
A part of the East 1/4 of the S.W.1/4 and of the West 1/4 of the S.E.1/4 all of Section 35, T5N, R3W of the 4th P.M. Grant County, Wisconsin; described as follows to-wit; Begin at a point which is 1131.90 feet North and 460.00 feet East of the Southwest corner of the East 1/4 of the S.W.1/4 of said Section 35; thence North 500.00 feet to the South Right-of-Way line of U.S.#61; thence North 82° 23' East 404.1 feet along the South line of U.S.#61 Right-of-Way; thence South 552.47 feet; thence West 400.00 feet to the point of beginning.

George H. Kettler
George H. Kettler
11/8 - 11/16/71

Homer D. Ralph, Jr.
Homer D. Ralph, Jr.
Surveyor for Grant
County, Wisconsin

