


HOWELL

NORTHEAST CORNER
OF THE N.W. 1/4 OF
THE S.E. 1/4 OF SEC.
15, T 6 N, R 3 W.

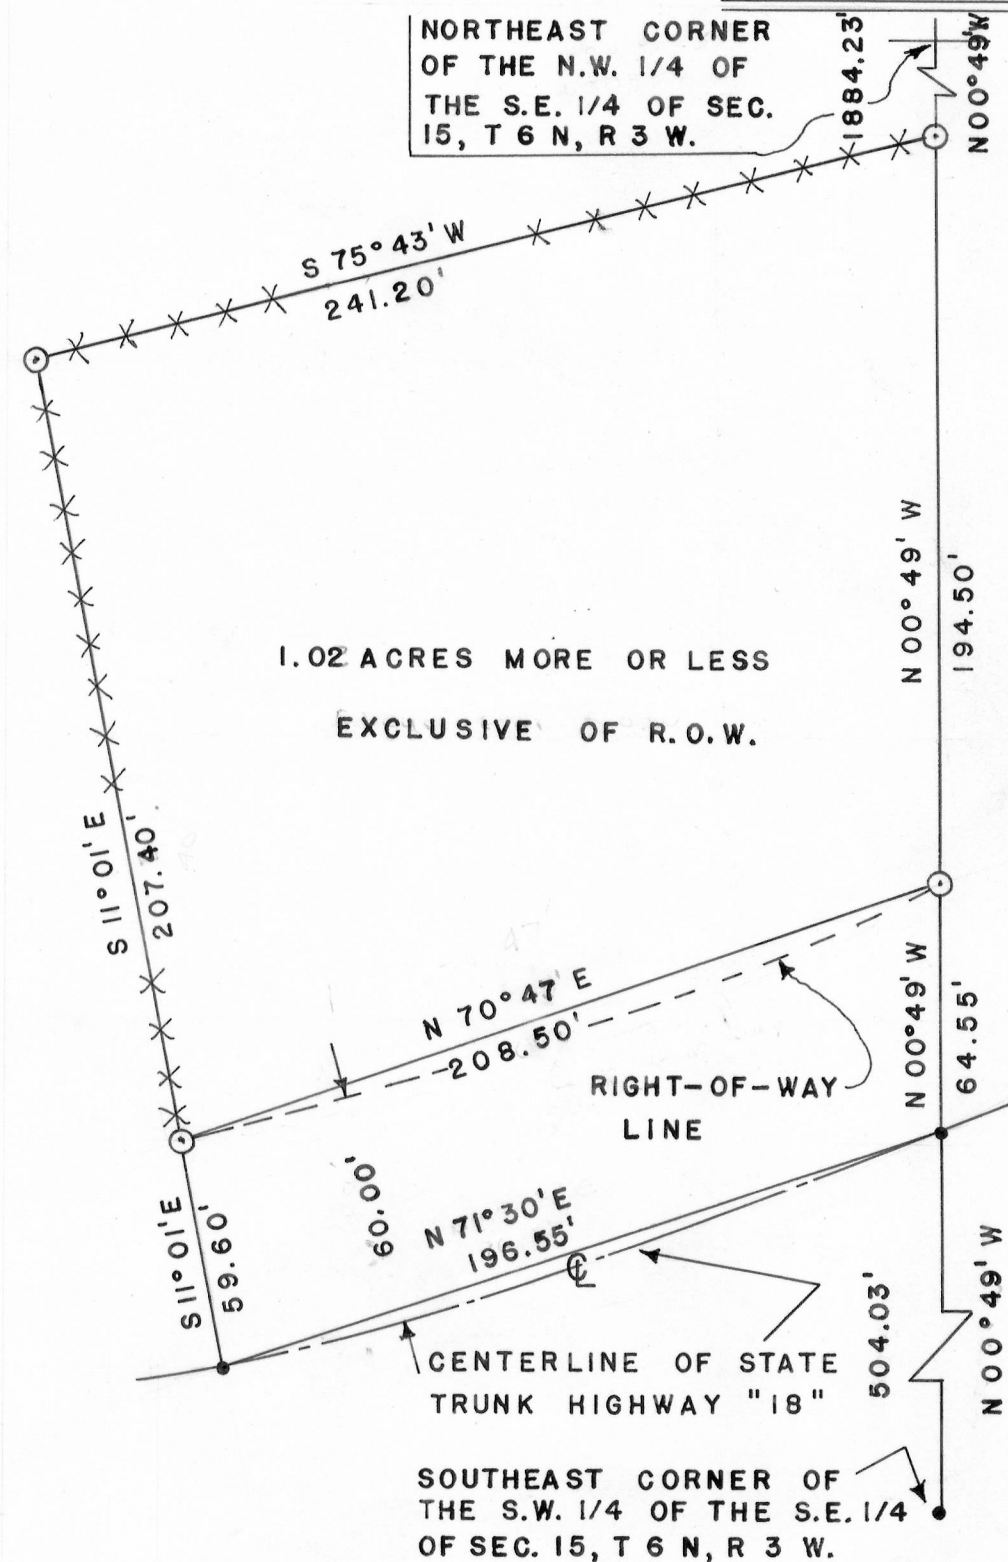


DESCRIPTION:

Part of the S.W.1/4 of the S.E.1/4 of Section 15, T 6 N, R 3 W, of the 4th P.M., Grant County, Wisconsin, described as follows to-wit: Begin at the Southeast corner of the S.W.1/4 of the S.E.1/4 of said Section 15; thence North 00° 49' West 504.03 feet to a point on the centerline of State Trunk Highway "18" and the point of beginning; thence southwesterly along the arc of a curve concave to the North of radius 1637.10 feet whose chord bears South 71° 30' West 196.55 feet; thence North 11° 01' West 267.00 feet; thence North 75° 43' East 241.20 feet; thence South 00° 49' East 259.05 feet to a point on the centerline of S.T.H. "18" and the point of beginning. Containing 1.02 acres more or less exclusive of highway right-of-way.

LEGEND:

- 1" X 24" IRON PIPE
- NAIL
- *** FENCE

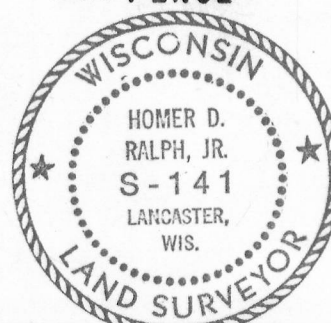

Homer D. Ralph, Jr.
HOMER D. RALPH JR.
SUEYOR FOR GRANT
COUNTY, WISCONSIN

David K. Krohn
DAVID K. KROHN
7/27/74 - 8/2/74

SCALE: 1" = 50'

