



TITLBACH — BRANDEMUEHL SURVEY

N

LEGEND:

- 1" X 24" IRON PIPE PLACED BY THIS SURVEY
- NAIL PLACED BY THIS SURVEY

SCALE: 1" = 60'

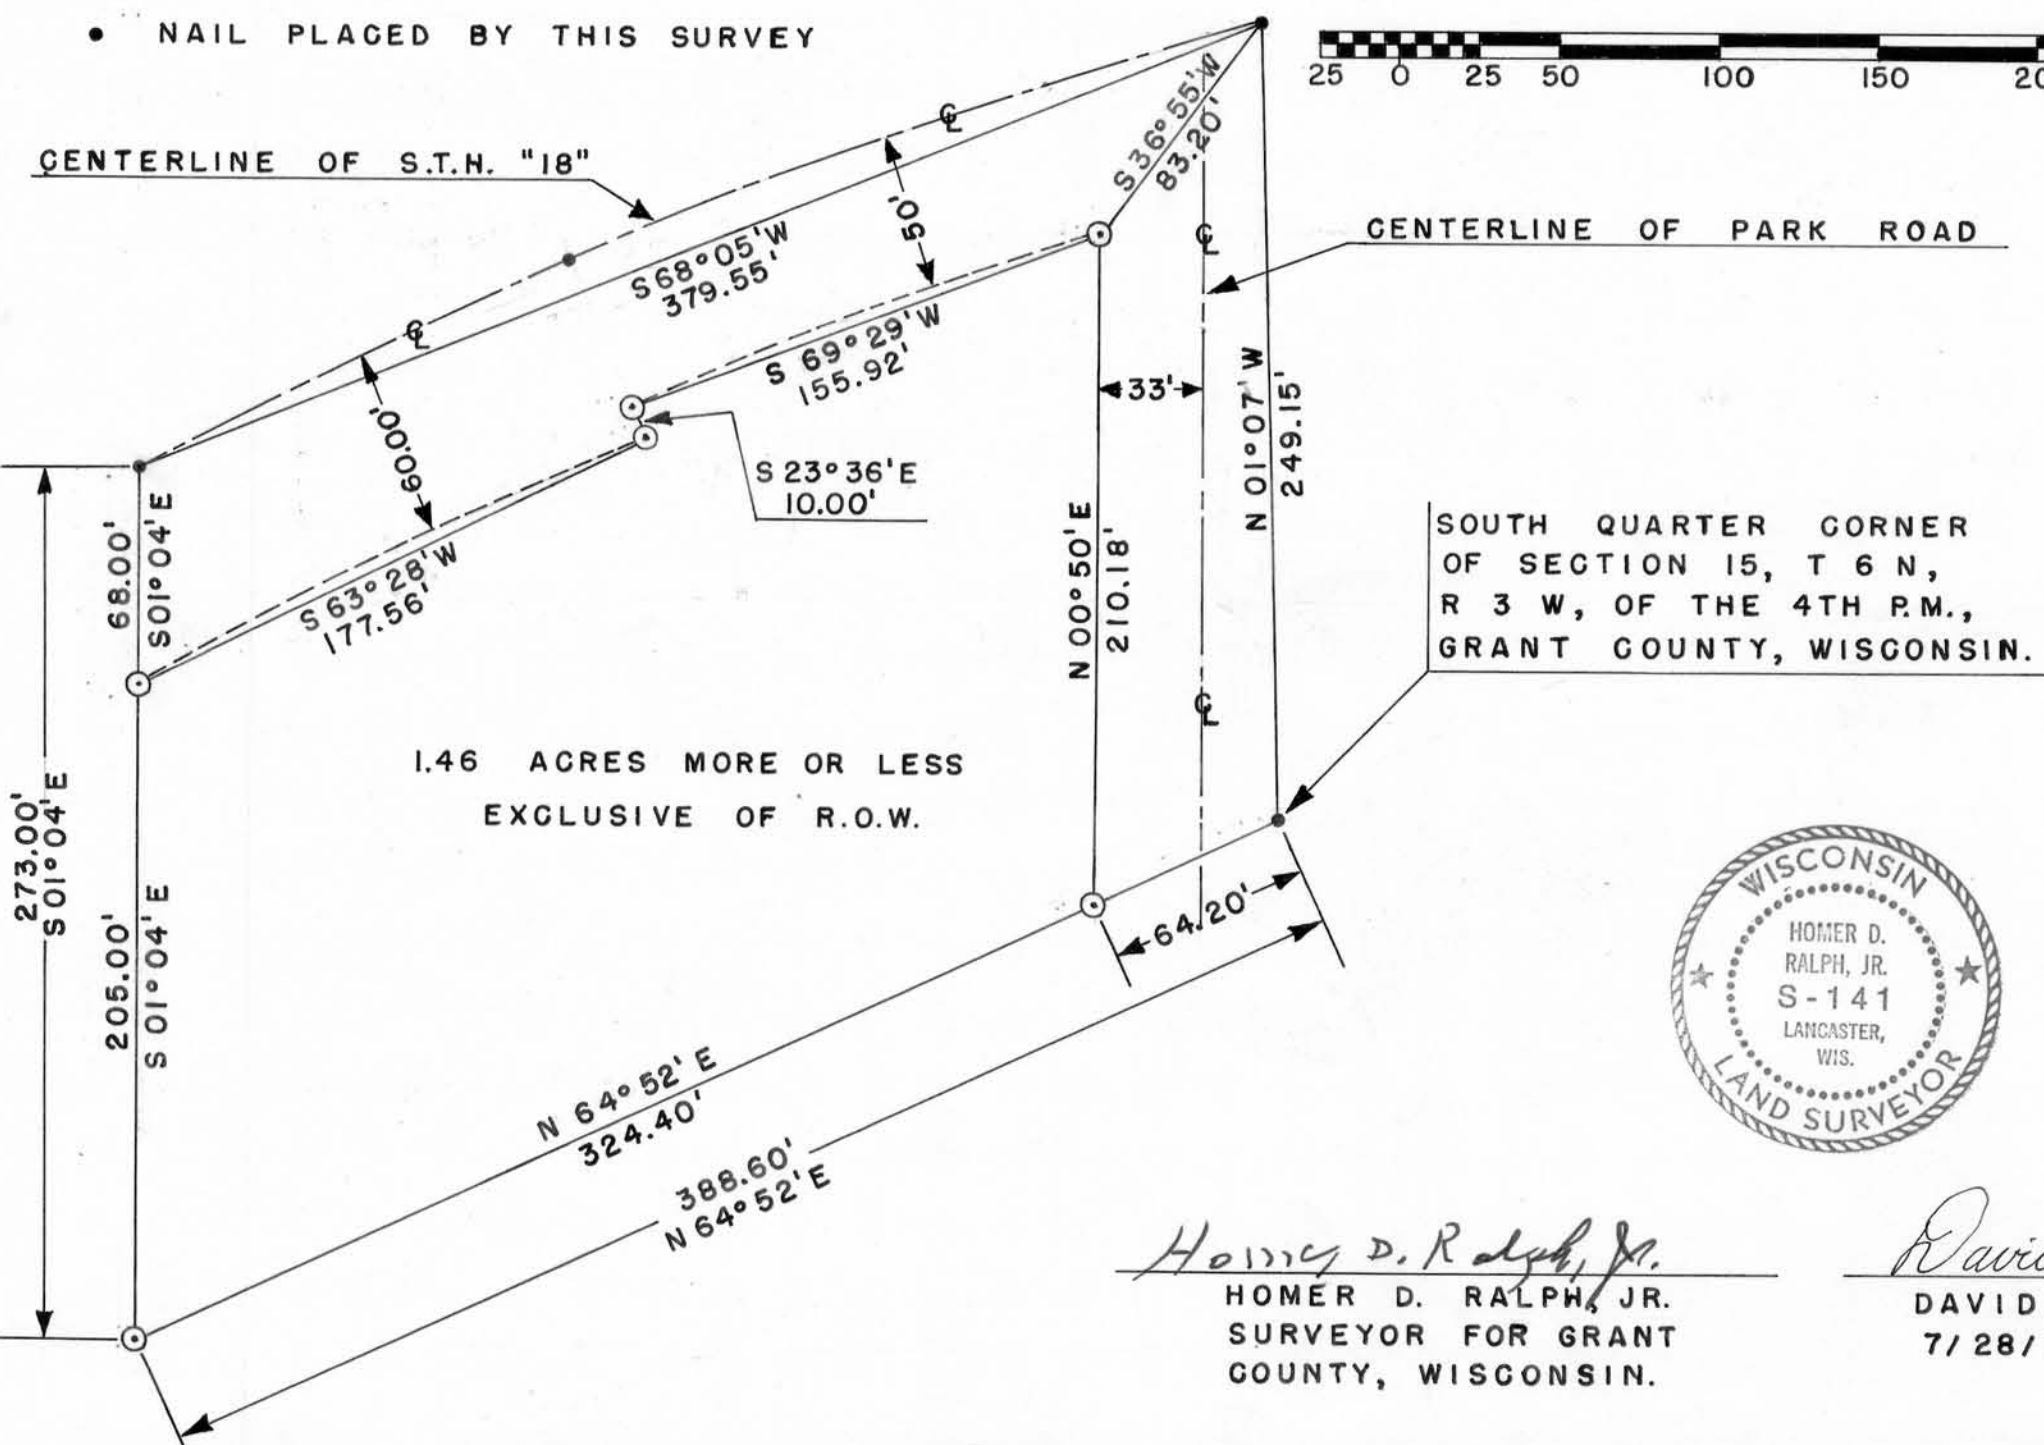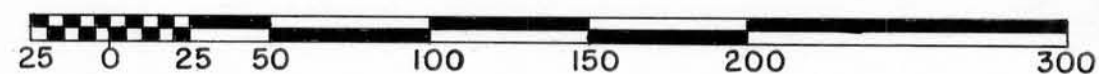

Homer D. Ralph, Jr.
HOMER D. RALPH, JR.
SURVEYOR FOR GRANT
COUNTY, WISCONSIN.

David K. Krohn
DAVID K. KROHN
7/28/74 — 8/28/74

TITLBACH - BRANDEMUEHL

DESCRIPTION:

Part of the S.E.1/4 of the S.W.1/4 of Section 15, and part of the N.E.1/4 of the N.W.1/4 of Section 22, all in T 6 N, R 3 W, of the 4th P.M., Grant County, Wisconsin, described as follows to-wit;

Begin at the South Quarter Corner of said Section 15;

thence South $64^{\circ} 52'$ West 388.60 feet;

thence North $01^{\circ} 04'$ West 273.00 feet to a point on the centerline of State Trunk Highway "18";

thence Northeasterly along the arc of a curve concave to the South of radius 1637.10 feet and whose chord bears North $68^{\circ} 05'$ East 379.55 feet;

thence South $01^{\circ} 07'$ East 249.15 feet to the South Quarter Corner of Section 15 and the point of beginning.

Containing 1.46 acres more or less exclusive of highway right-of-way.

Homer D. Ralph, Jr.

Homer D. Ralph, Jr.
Surveyor for Grant
County, Wisconsin.