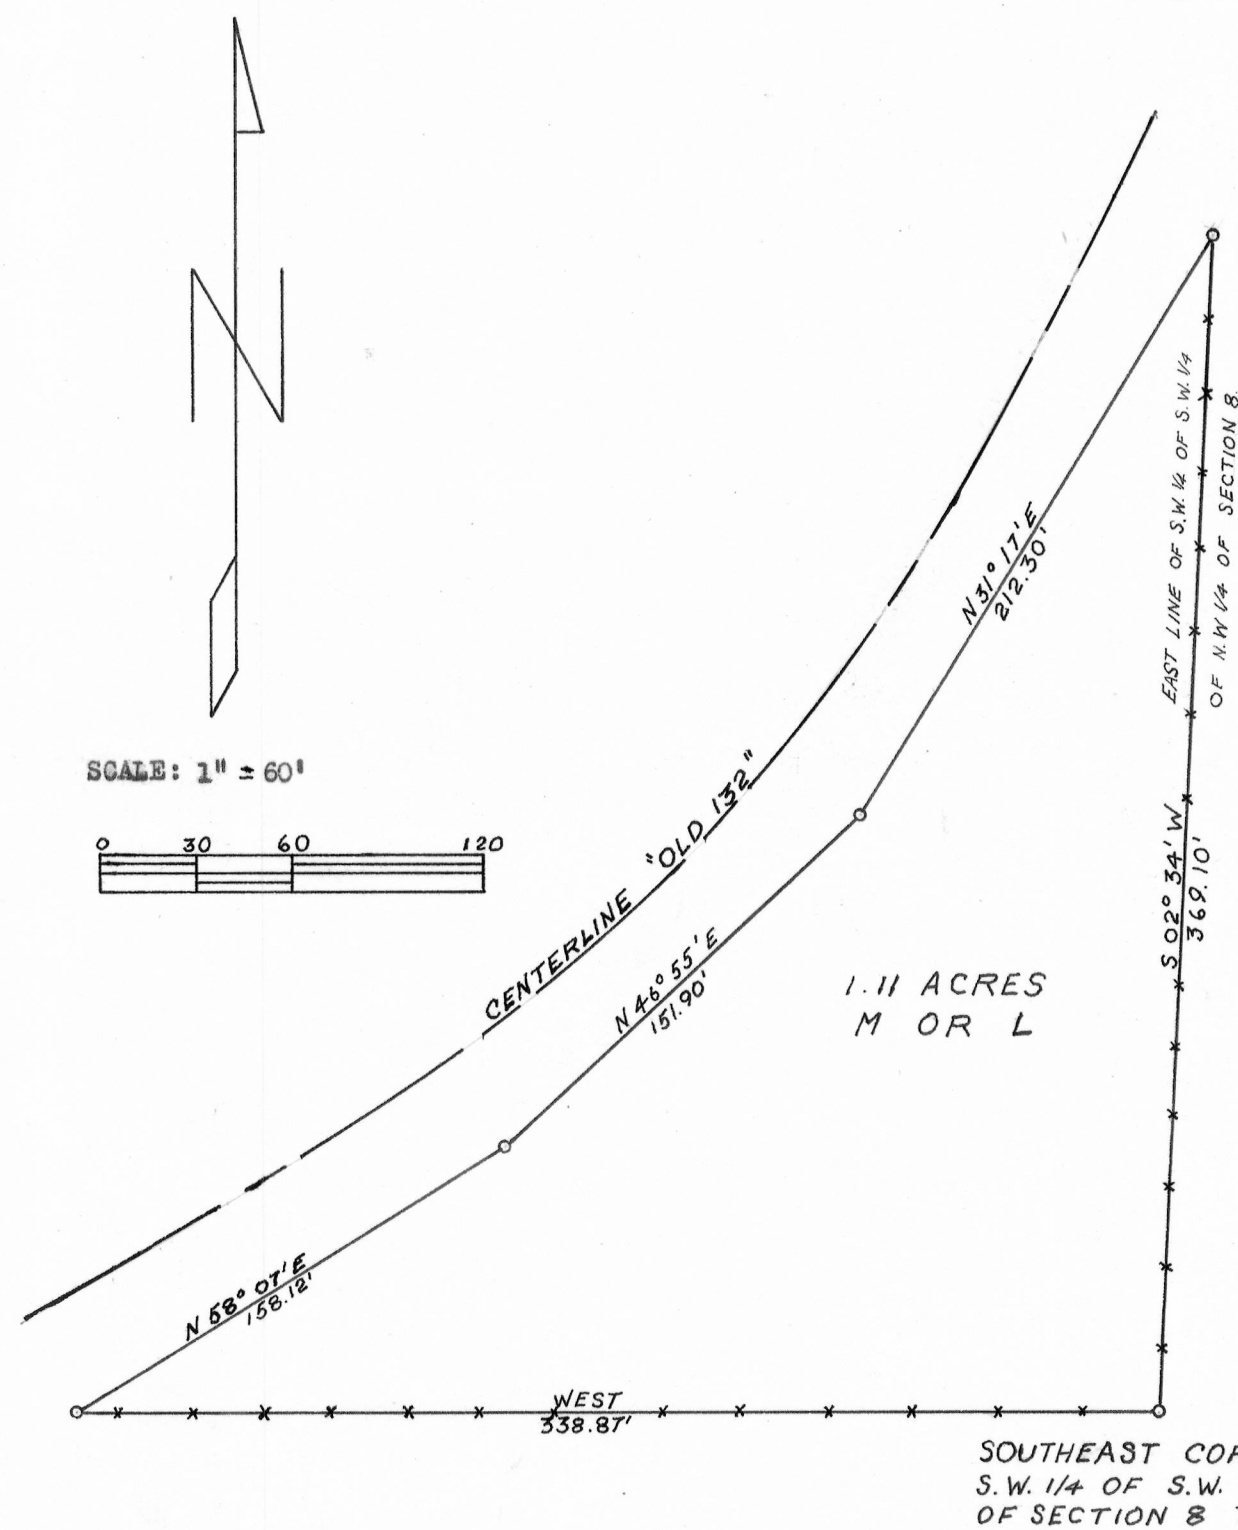



HUDSON SURVEY

DESCRIPTION:

A part of the S.W. 1/4 of S.W. 1/4 of N.W. 1/4 of Section 8, T 7 N, R 3 W, of the 4th. P.M., Grant County, Wisconsin, described as follows to-wit;

Begin at the Southeast Corner of the S.W. 1/4 of S.W. 1/4 of N.W. 1/4 of said Section 8; thence West 338.87 feet to the Southerly right-of-way of Town Road "Old 132"; thence North 58° 07' East 158.12 feet along a chord of the curve of said right-of-way; thence North 46° 55' East 151.90 feet along a chord of the curve of said right-of-way; thence North 31° 17' East 212.30 feet along a chord of the curve of said right-of-way; thence South 02° 34' West 369.10 feet to the point of beginning. Containing 1.11 acres more or less.

- 1" X 24" iron pipe placed by this survey.

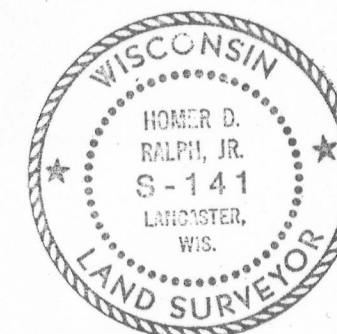

John F. Elwell
John F. Elwell
6/5/73 - 6/5/73

Homer D. Ralph, Jr.
Homer D. Ralph, Jr.
Surveyor for Grant
County, Wisconsin.