

DESCRIPTION OF LANDS TO BE CONVEYED BY DAVID EARL HUBBEL  
AND MARGARET MAE, HIS WIFE TO STATE OF WISCONSIN -  
CONSERVATION DEPARTMENT.

---


That part of Government Lot 2 and the West  $1/2$  of S.E.  $1/4$ ,  
all in Section 13, T 8 N, R 3 W. of the 4th P.M., Grant  
County, Wisconsin, which lies North and West of the  
following described line:

Commence at the South Quarter corner of said Section  
13; thence West 13.97 feet to a point on the centerline  
of a road; thence North  $01^{\circ} 57'$  West 702.25 feet along  
said centerline; thence North  $27^{\circ} 13'$  East 82.80 feet  
to a point on the North and South Quarter Section line  
of said Section 13, and the Southwestern end of the line  
to be described; thence North  $27^{\circ} 13'$  East 2304.80 feet,  
more or less, to a point on the Southern boundary of the  
Wisconsin River, and the Northeastern end of the line  
being described.

State of Wisconsin) ss  
County of Grant )

I, Homer D. Ralph, Jr., Surveyor for Grant County, Wisconsin  
hereby certify that on the 28th day of January, A.D., 1961,  
With the help of Robert W. Lorenz and Lewis E. Myers, I sur-  
veyed a part of Section 13, T 8 N, R 3 W. of the 4th P.M.,  
Grant County, Wisconsin, and that the above description and  
the attached map are true and correct representations of  
said survey.

*Homer D. Ralph, Jr.*  
Homer D. Ralph, Jr.  
Surveyor for Grant Co., Wis.  
Wis. Reg. No. S-141  
2/27/61

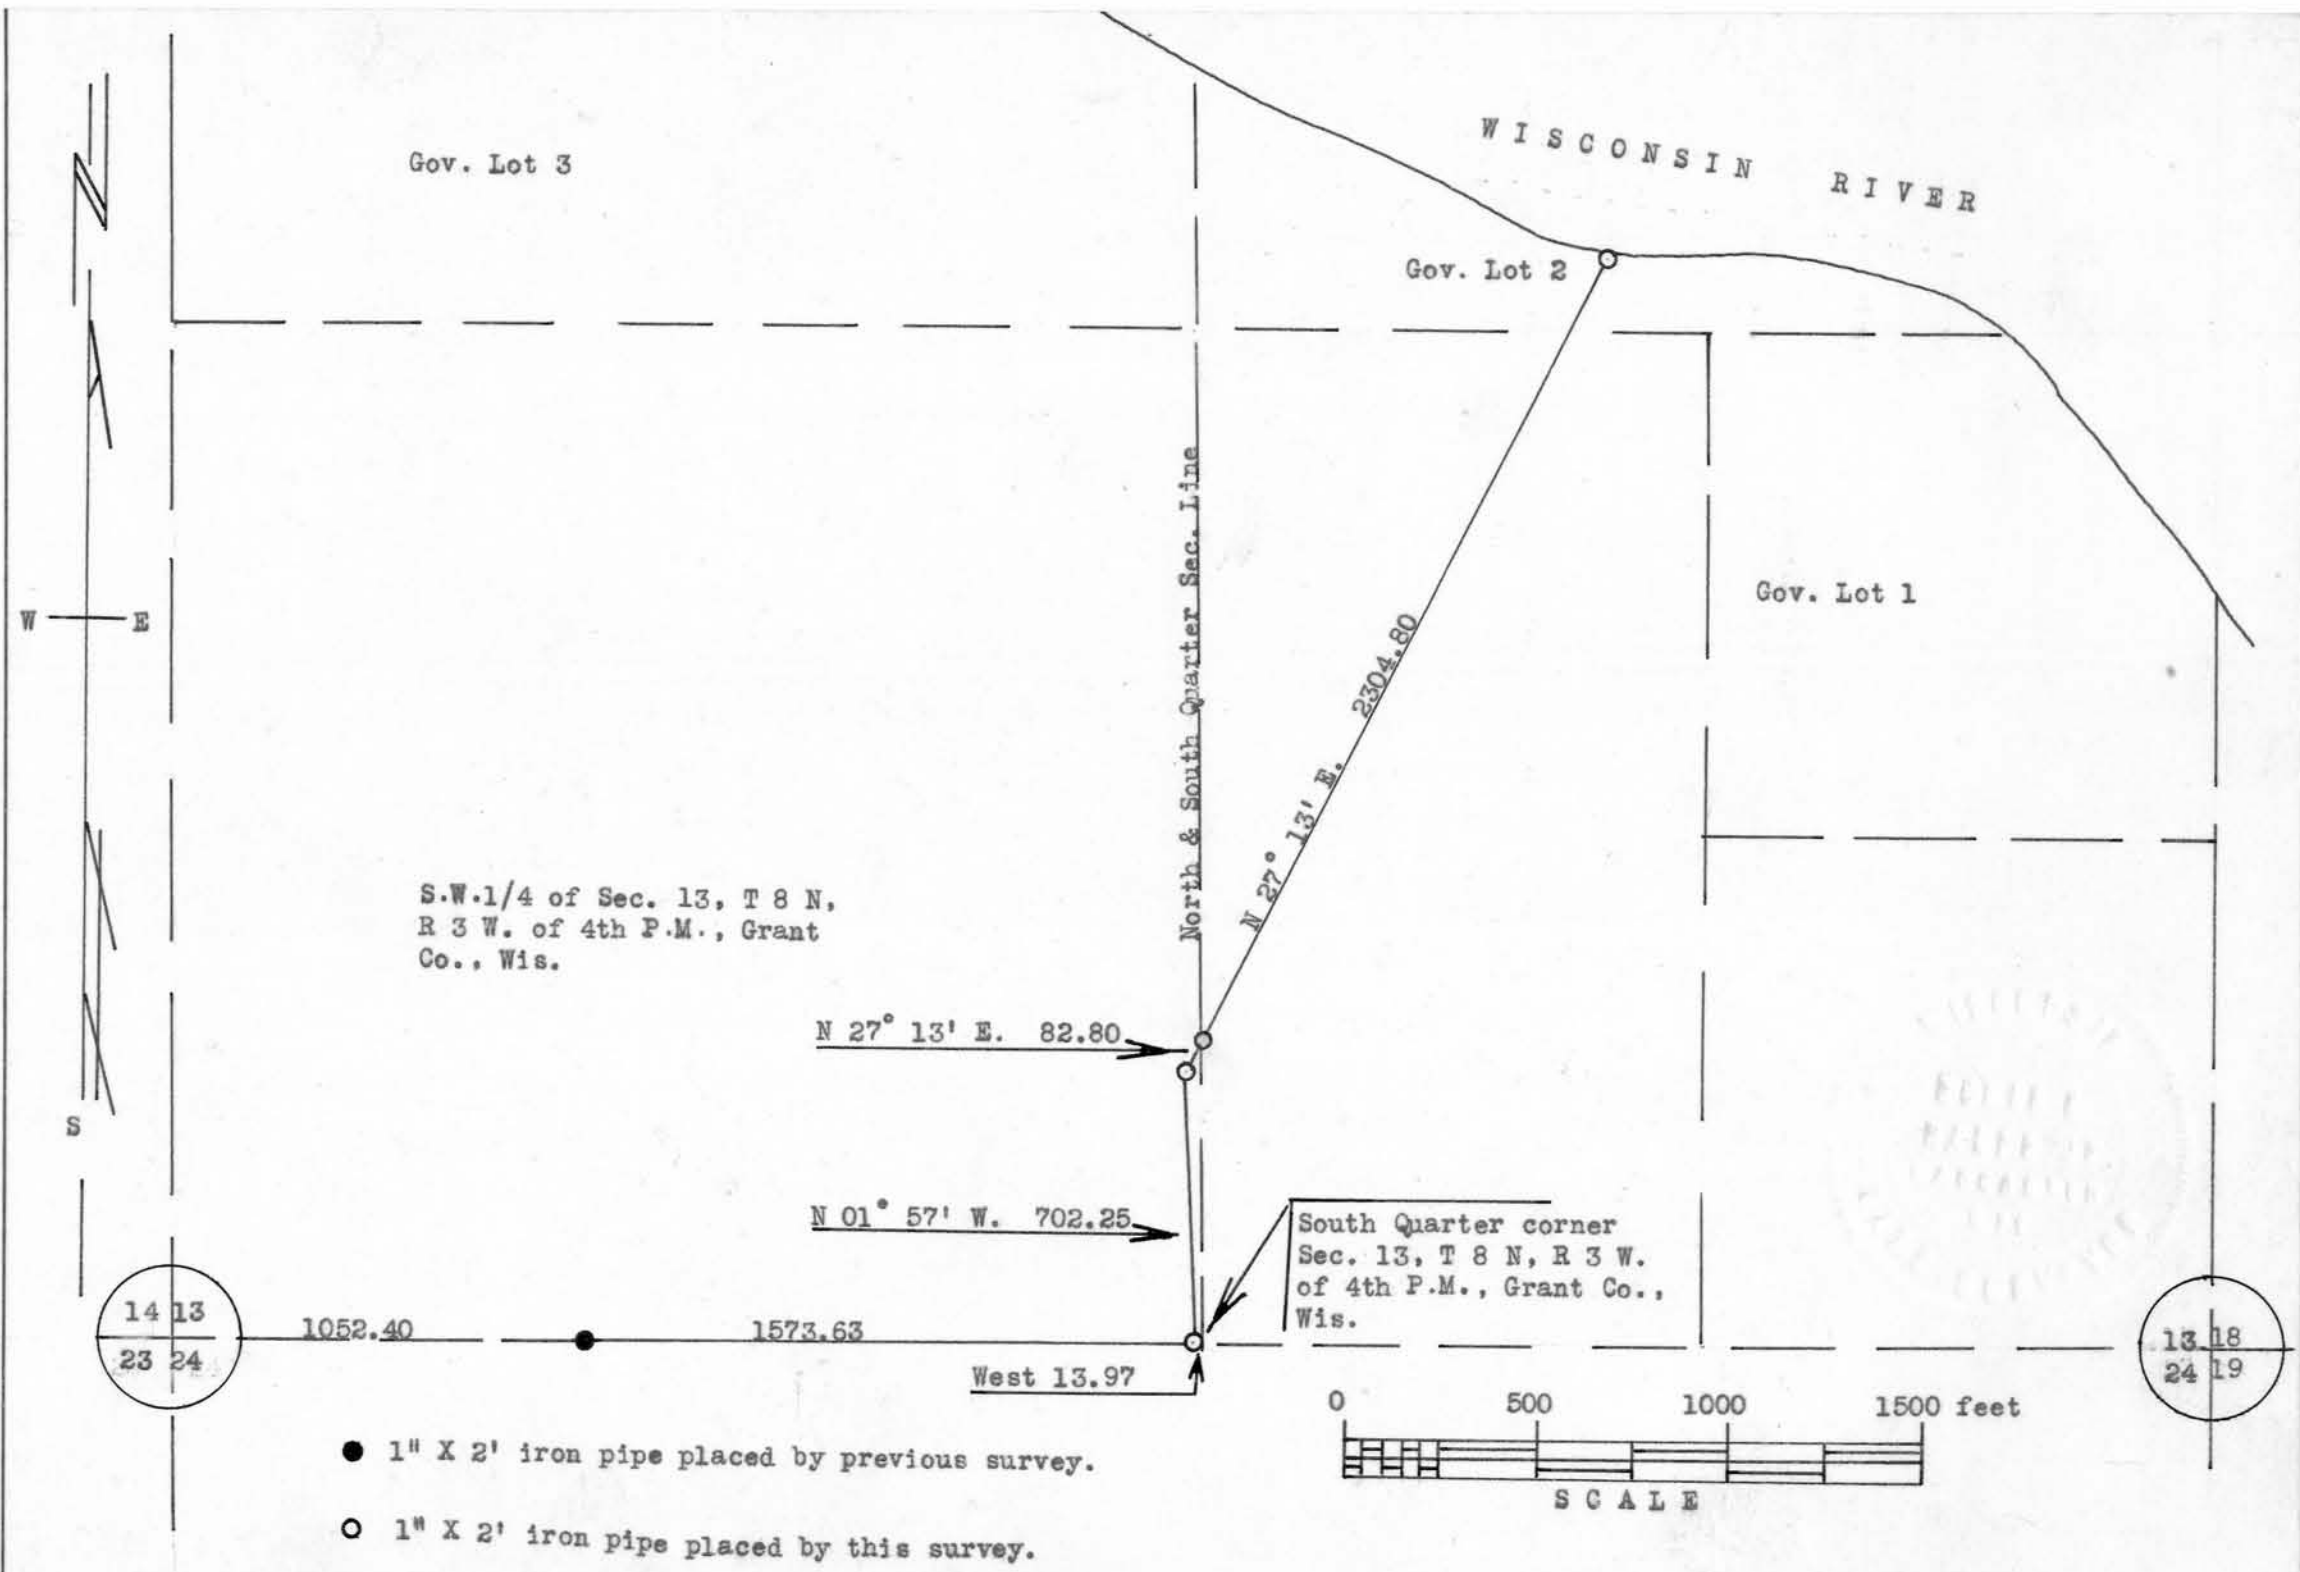

- 1" X 2' iron pipe placed by previous survey.
- 1" X 2' iron pipe placed by this survey.