


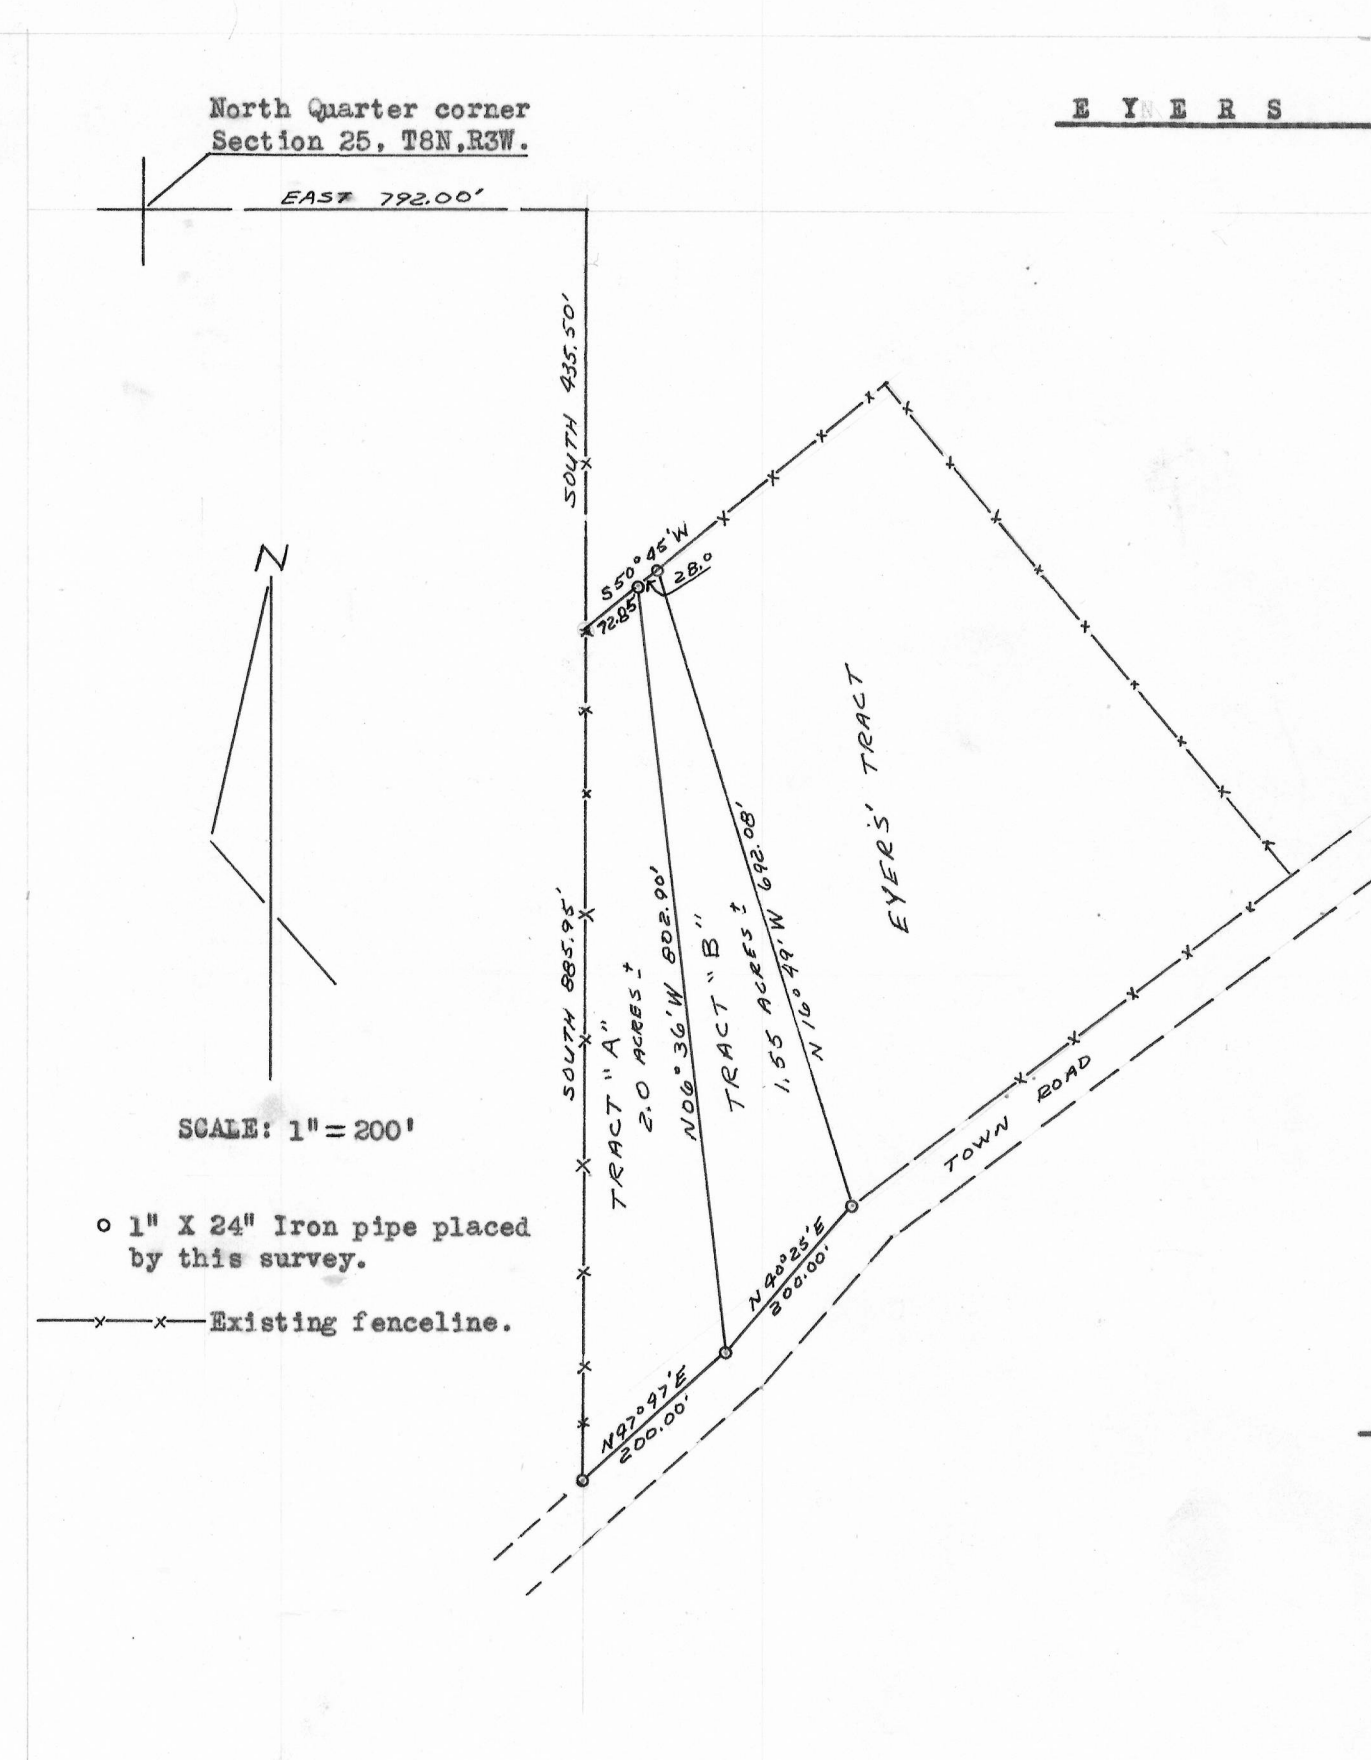

E Y E R S S U R V E Y

DESCRIPTIONS: Tract "A"

Part of the N.W.1/4 of the N.E.1/4 of Section 25, T 8 N, R 3 W. of the 4th P.M., Grant County, Wisconsin, described as follows:

Begin at a point which is 792.00 feet East and 435.50 feet South of the North Quarter corner of said Section 25; thence South 885.95 feet; thence North 47° 47' East 200.00 feet; thence North 06° 36' West 802.90 feet; thence South 50° 45' West 72.85 feet to the place of beginning. Containing 2.0 acres more or less.

Tract "B"

Part of the N.W.1/4 of the N.E.1/4 of Section 25, T 8 N, R 3 W. of the 4th P.M., Grant County, Wisconsin, described as follows:

Begin at a point which is East 792.00 feet; thence South 435.50 feet; thence North 50° 45' East 72.85 feet/ from the North Quarter corner of said Sec. 25; thence South 06° 36' East 802.90 feet; thence North 40° 25' East 200.00 feet; thence North 16° 49' West 692.08 feet; thence South 50° 45' West 28.00 feet to the place of beginning. Containing 1.55 acres more or less.

o 1" X 24" Iron pipe placed by this survey.

--- Existing fenceline.

Charles Lange
Charles Lange
2/24/73 - 3/3/73

Homer D. Ralph, Jr.
Homer D. Ralph, Jr.
Surveyor for Grant County, Wisconsin.

