


BOSCOBEL DEVELOPERS, LTD.

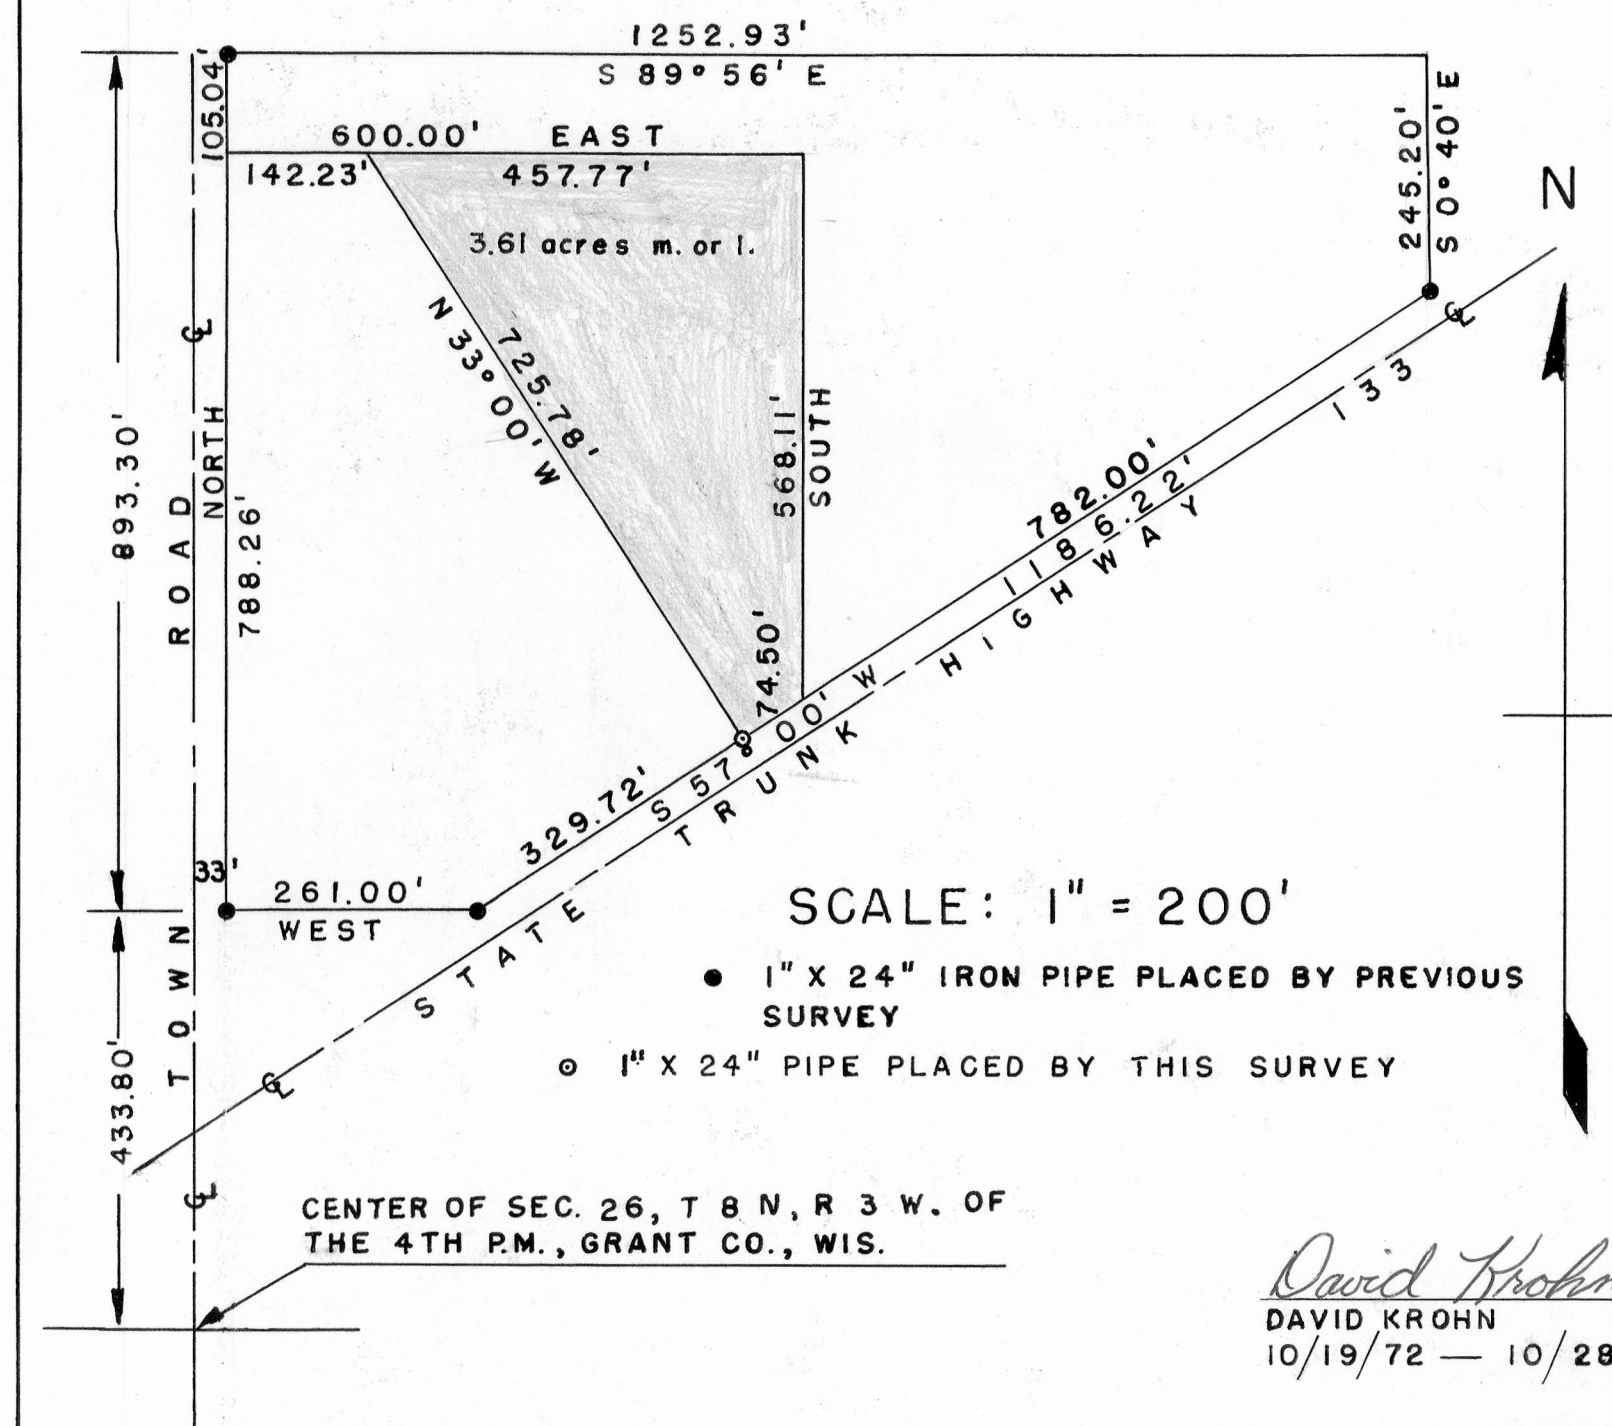

DESCRIPTION:

A part of the S.W.1/4 of the N.E.1/4 of Section 26,
T 8 N, R 3 W, of the 4th P.M., Grant County,

Wisconsin, described as follows to-wit:

Begin at a point which is 1222.06 feet North and
175.23 feet East of the Center of said Section 26;
thence East 457.77 feet; thence South 568.11 feet;
thence South 57° 00' West 74.50 feet; thence North
33° 00' West 725.78 feet to the place of beginning.

Containing 3.61 acres more or less.



David Krohn
DAVID KROHN
10/19/72 — 10/28/72

Homer D. Ralph, Jr.
HOMER D. RALPH, JR.
SURVEYOR FOR GRANT
COUNTY, WISCONSIN.