


FRED BROWN SURVEY

N

NEVADA STREET

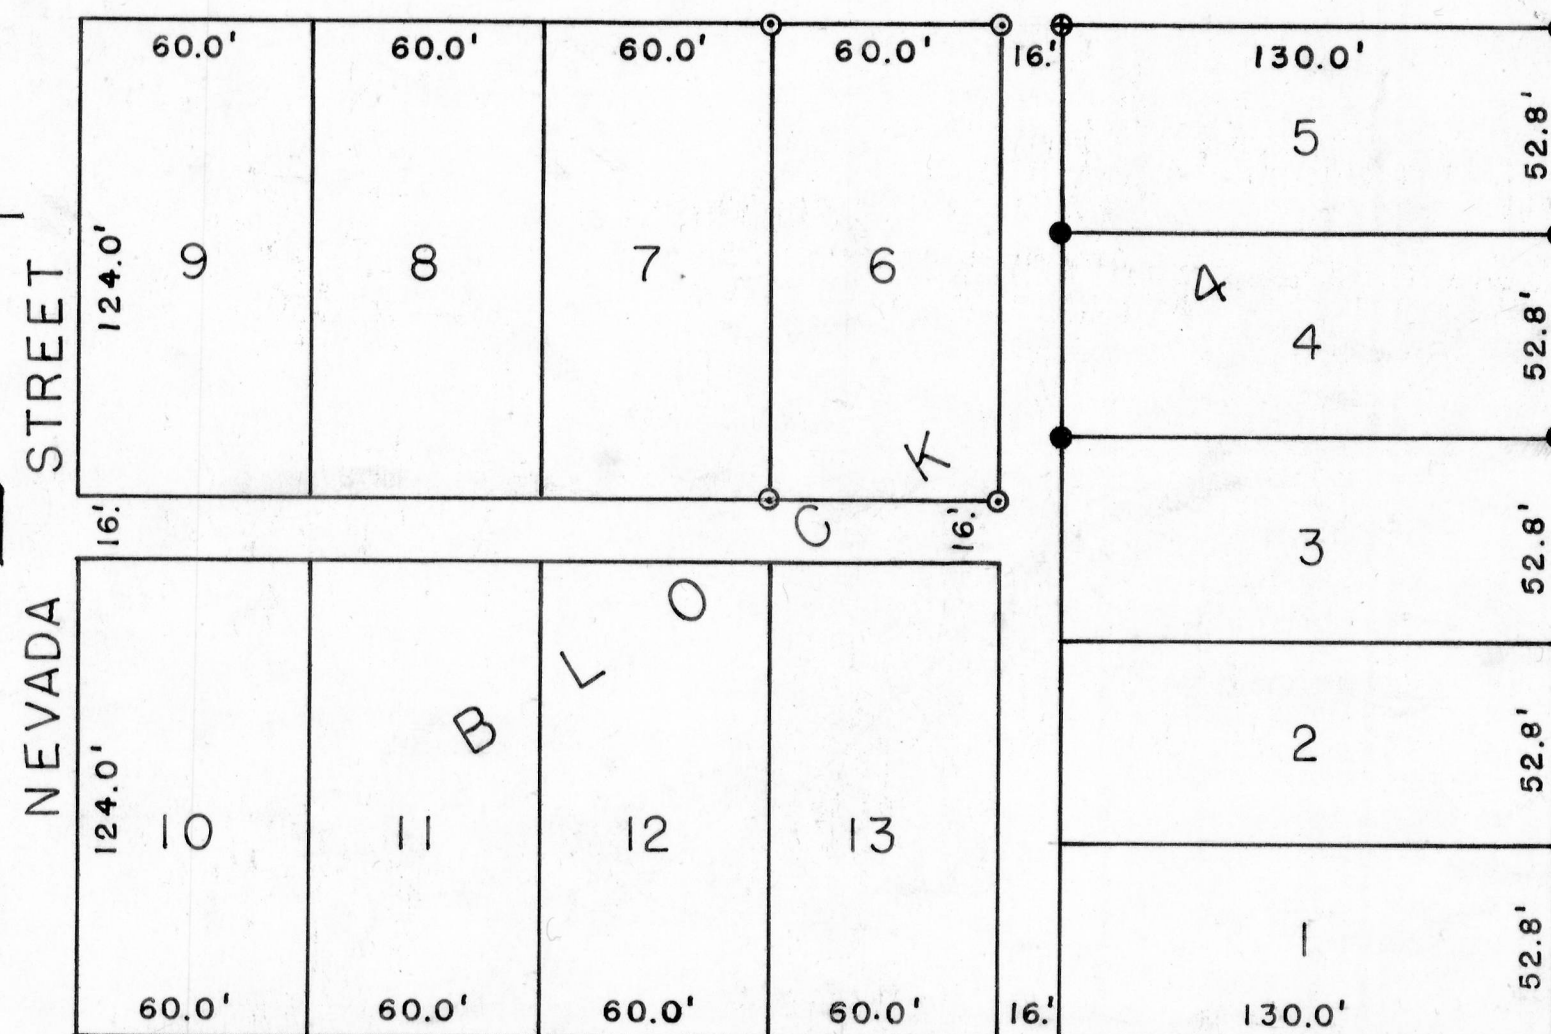


PRAIRIE STREET

SCALE: 1" = 50'

- ⊙ 1" X 24" PIPE PLACED BY THIS SURVEY
- ⊕ RAILROAD SPIKE PLACED BY THIS SURVEY
- IRON PIPE PLACED BY PREVIOUS SURVEY

Description:

Lots 4, 5, and 6 in Block 4 of the Original
Plat of the Village (now City) of Boscobel,
Grant County, Wisconsin, according to the
recorded map or plat thereof.

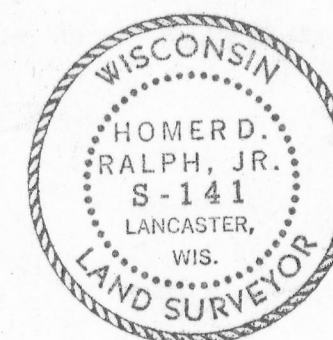

David Krohn
David Krohn
11/7/71 - 11/20/71

Homer D. Ralph, Jr.
Homer D. Ralph, Jr.
Surveyor for Grant Co.
Wisconsin