


GUDIE SURVEY

SCALE 1"=100'

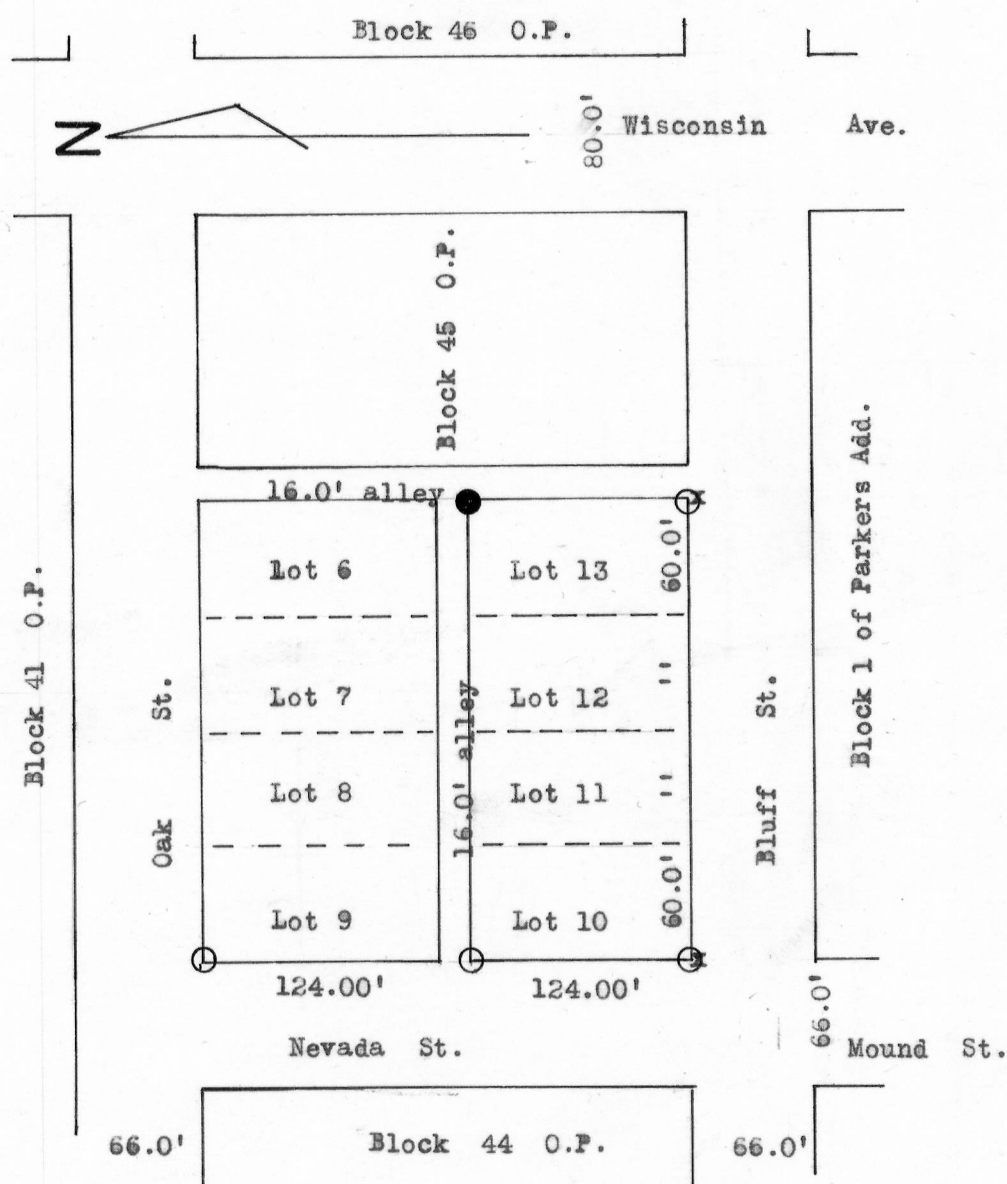

Description:

Lots 10, 11, 12 & 13, Block 45 of the Original
Flat of the Village (now City) of Boscobel,
Grant County, Wisconsin.

Legend:

- Denotes 1"x24" iron pipe
- Denotes railroad spike
- x Mark on sidewalk 4 feet South of Lot corner.

Lewis Seymour
Lewis Seymour 4/18/70-
4/21/70

Homer D. Ralph Jr.
Homer D. Ralph Jr.
Surveyor for Grant County,
Wisconsin.

