


DE GAYNER HOMES INC. SURVEY
SCALE 1" = 20'

SUPERIOR STREET

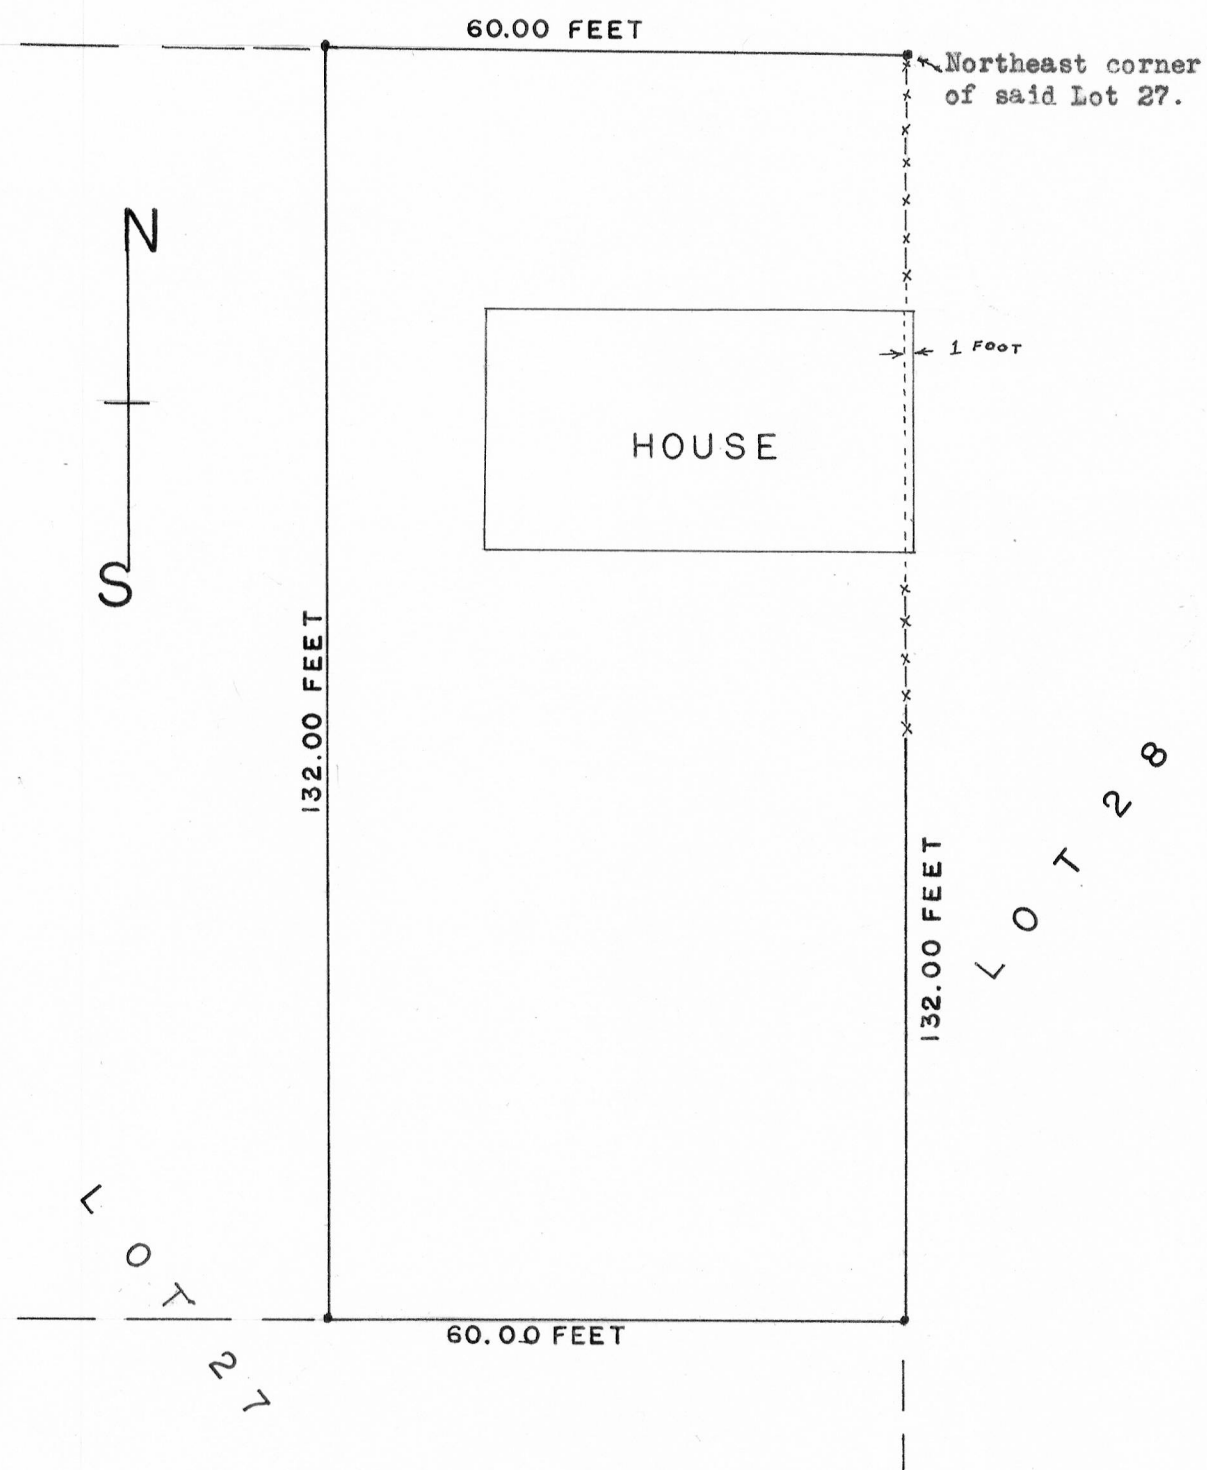

DESCRIPTION:

The East 60.00 feet of the North 1/2 of Lot 27, Section 26, of the Assessment Plat of the City of Boscobel, Grant County, Wisconsin, described as follows, to-wit:
Begin at the Northeast corner of said Lot 27; thence West 60.00 feet; thence South 132.00 feet; thence East 60.00 feet; thence North 132.00 feet to the point of beginning.



Ralph Bourret
Ralph Bourret
6/15 - 6/26/73

Homer D. Ralph, Jr.
Homer D. Ralph, Jr.
Surveyor for Grant
County, Wisconsin.

• - 1" X 24" Iron pipe placed by this survey.