


GROSS SURVEY

SCALE: 1" = 50'

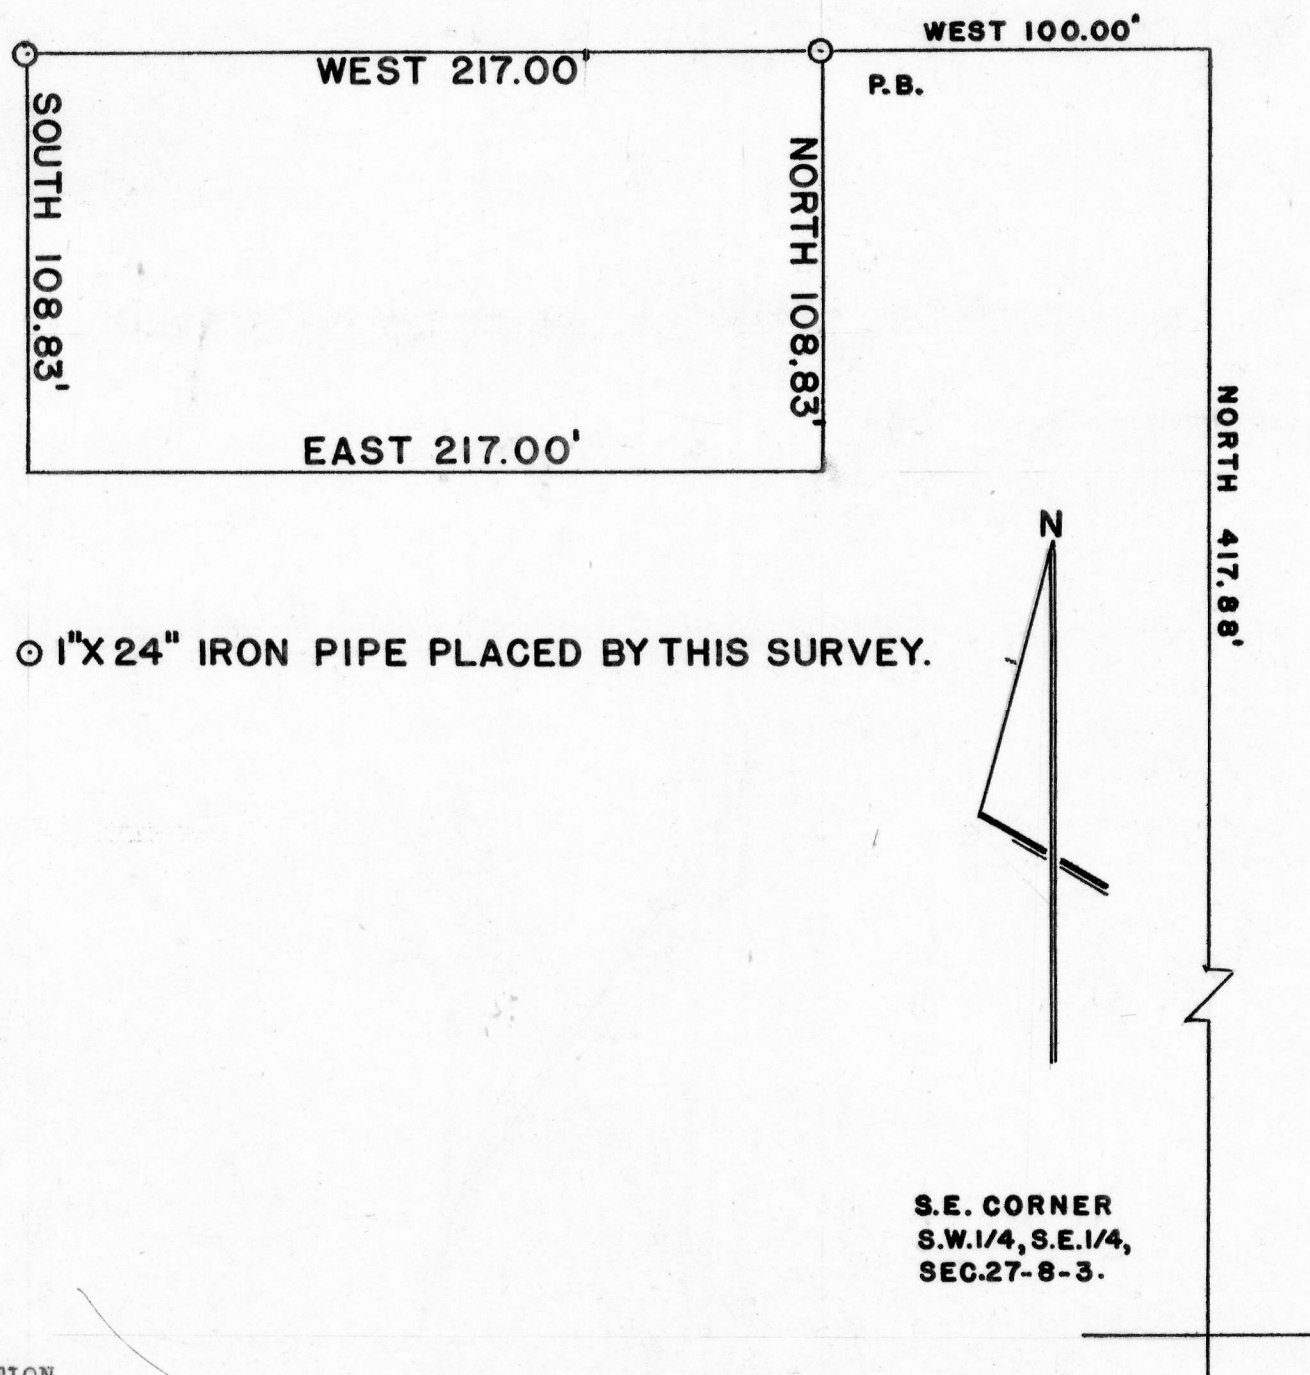


1"X24" IRON PIPE PLACED BY THIS SURVEY.

DESCRIPTION

Part of the S.W.1/4 of the S.E.1/4 of Section 27, T 8 N, R 3 W, of the 4th P.M., Grant County, Wisconsin described as follows to-wit:
Begin at a point 417.88 feet North and 100.00 feet West of the Southeast corner of said S.W.1/4; thence West 217.00 feet; thence South 108.83 feet; thence East 217.00 feet; thence North 108.83 feet to the place of beginning. Being designated on the Assessor's Plat of the City of Moscobel as ^{part of} Lot 34, Section 27.

Charles Lange
Charles Lange
2/20 - 3/10/71

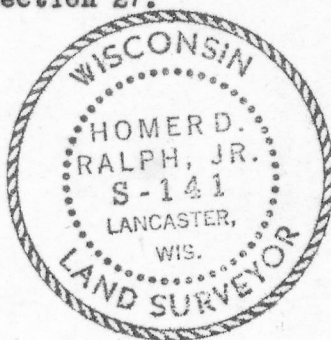

Homer D. Ralph, Jr.
Homer D. Ralph, Jr.
Surveyor for Grant
County, Wisconsin.