


HELLER SURVEY

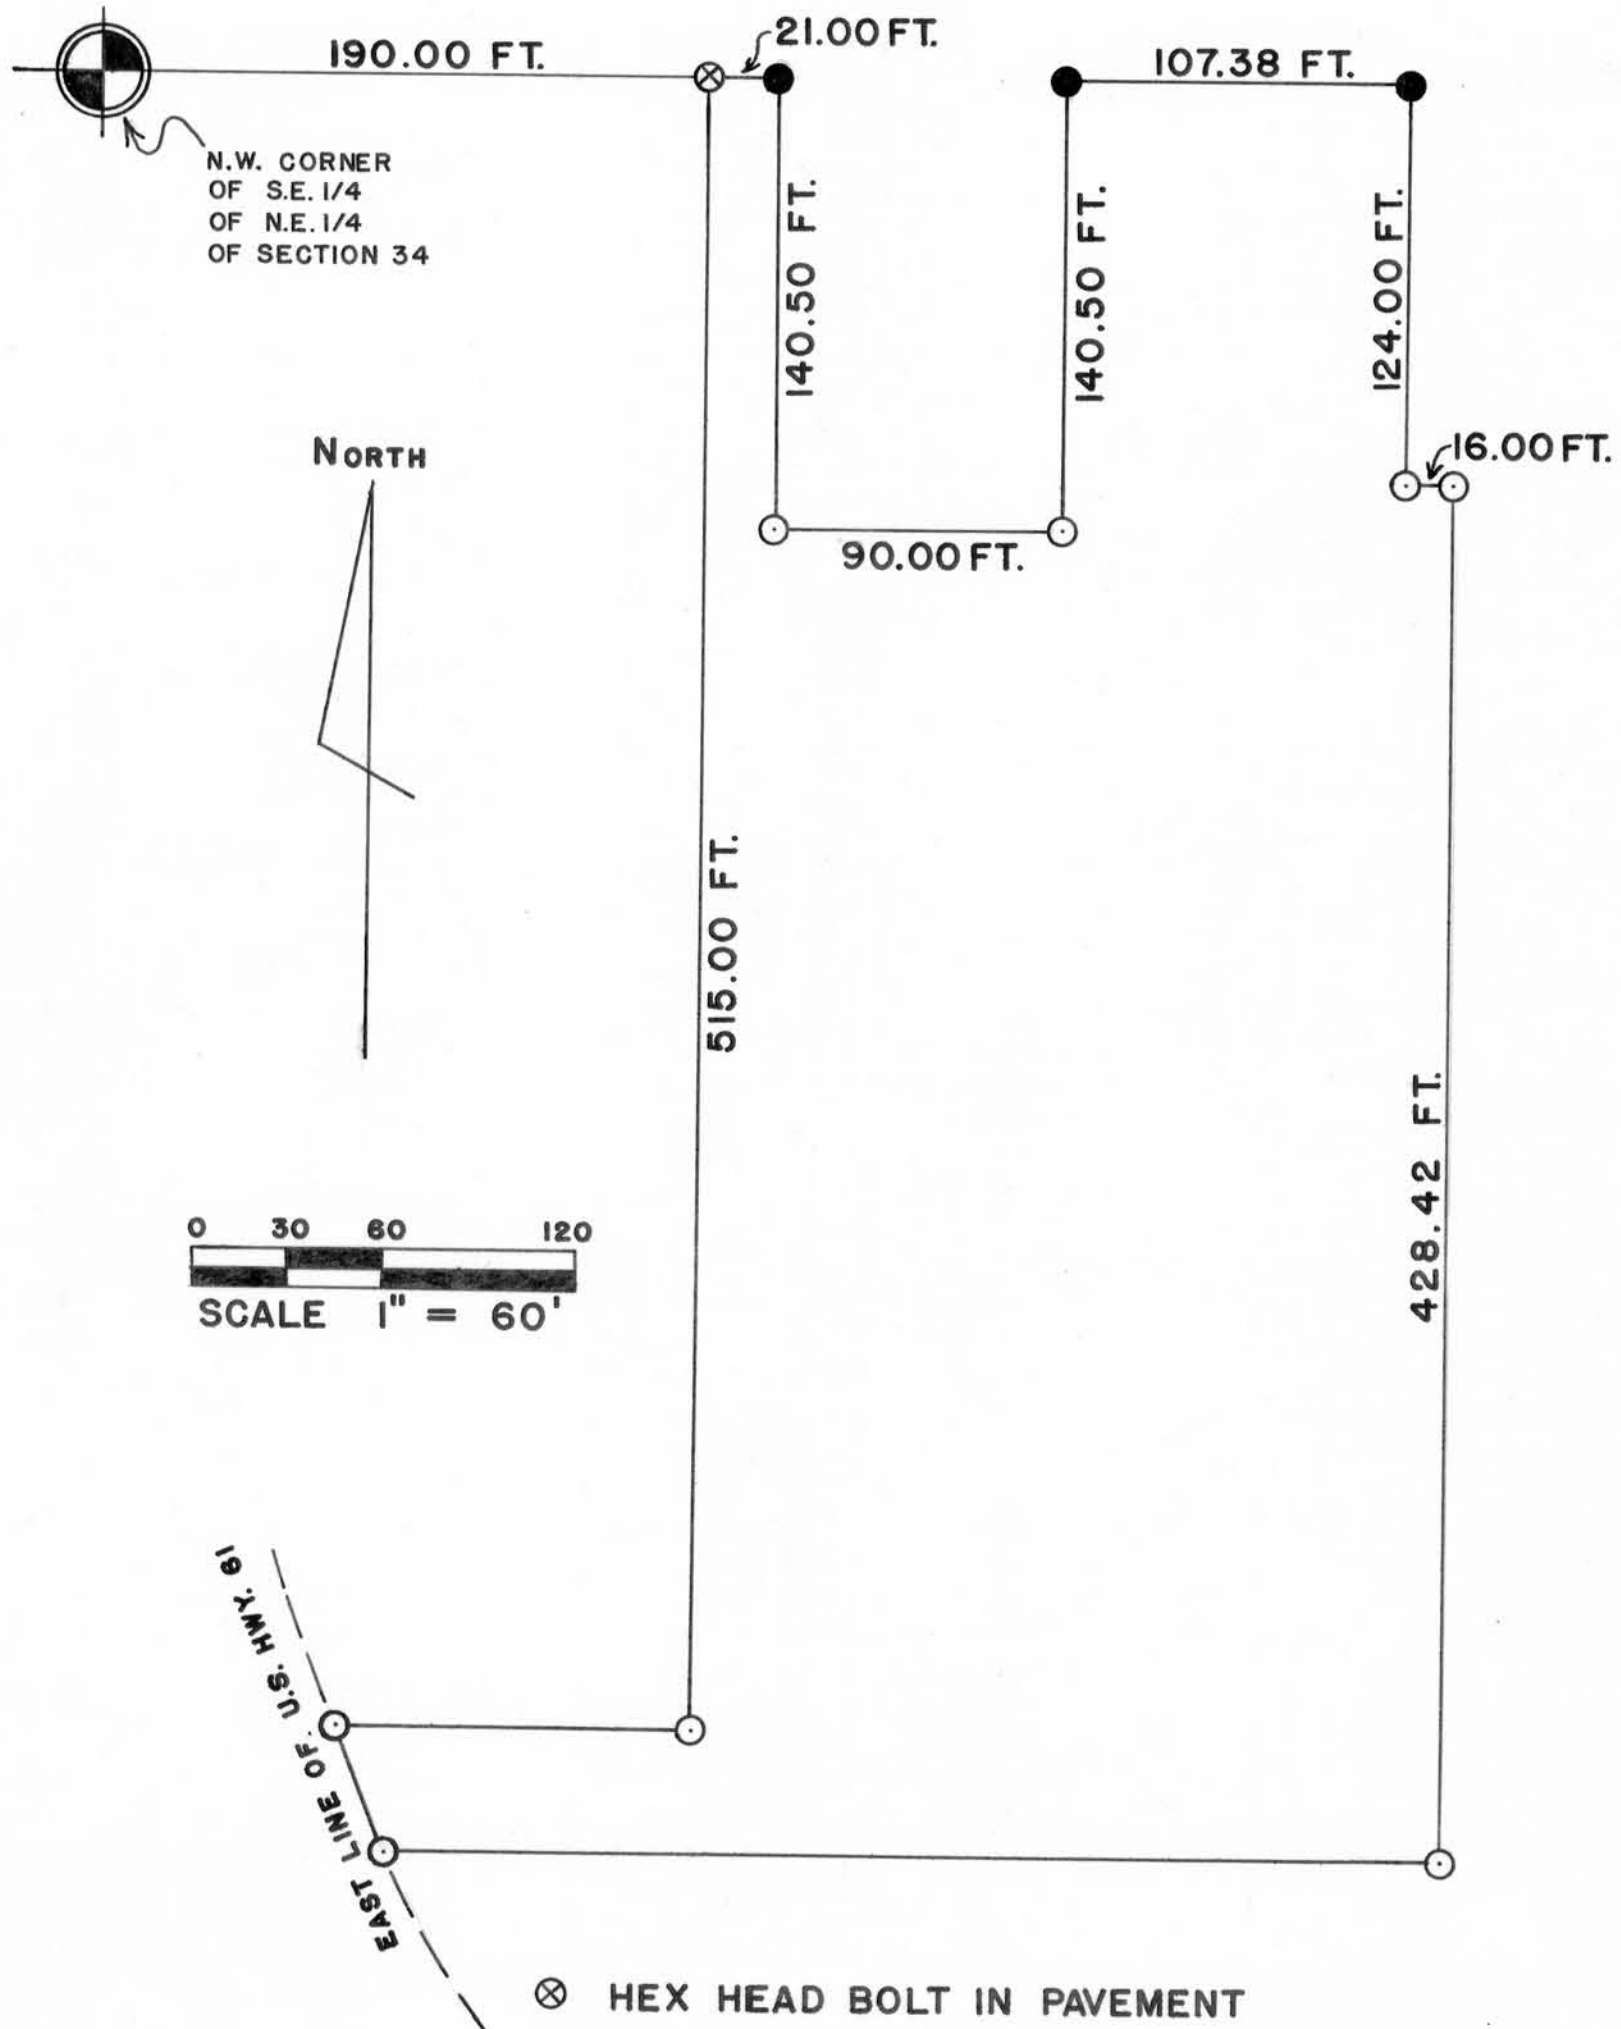

0 30 60 120
SCALE 1" = 60'

- ⊗ HEX HEAD BOLT IN PAVEMENT
- RAILROAD SPIKES IN PAVEMENT
- ⊙ 1"X24" IRON PIPE

Art Seymour
ART SEYMOUR
7/15 - 7/17/69



Homer D. Ralph, Jr.
HOMER D. RALPH, JR.
SURVEYOR FOR GRANT CO, WIS

Heller Description

A part of the S.E.1/4 of the N.E.1/4 of Section 34, T 8 N,
R 3 W. of the 4th P.M., Grant County, Wisconsin described
as follows to-wit:

Beginning at a point 408.38 feet East of the Northwest
corner of said S.E.1/4 of the N.E.1/4; thence South
124.00 feet; thence East 16.00 feet; thence South 428.42
feet; thence West to the East line of U.S. Hwy. #61;
thence Northwest along the East line of said highway to a
line 515.00 feet South of the North line of the S.E.1/4
of the N.E.1/4; thence East to a point 190.00 feet East
and 515.00 feet South of the Northwest corner of the
S.E.1/4 of the N.E.1/4; thence North 515.00 feet; thence
East 21.00 feet; thence South 140.50 feet; thence East
90.00 feet; thence North 140.50 feet; thence East 107.38
feet to the place of beginning. The above described lands
are designated on the Assessor's Plat of the City of
Boscobel as part of Outlot 19.

Art Seymour
Art Seymour
7/15 - 7/17/69



Homer D. Ralph, Jr.
Homer D. Ralph, Jr.
Surveyor for Grant Co.,
Wisconsin