


LARSON SURVEY

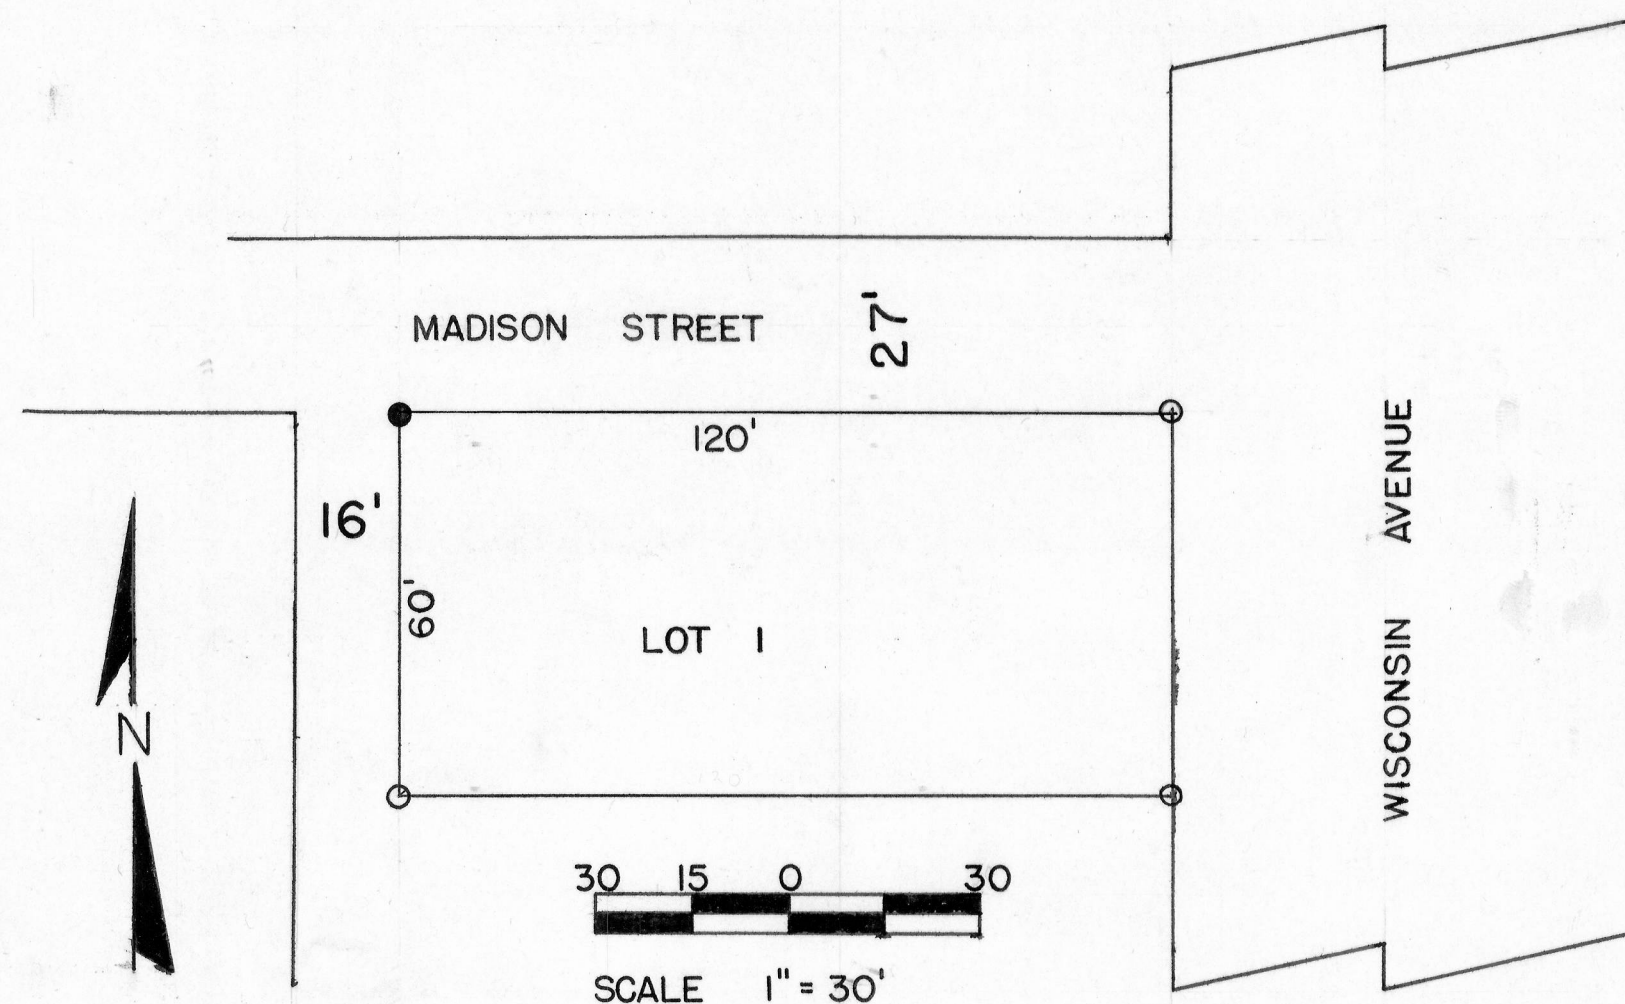

- 1" X 24" IRON PIPE
- RAILROAD SPIKE IN PAVEMENT

DESCRIPTION:
 LOT ONE (1) IN BLOCK THREE (3) OF THE SOUTHVIEW
 ADDITION TO THE VILLAGE NOW CITY OF
 BOSCOBEL, GRANT CO. WIS., ACCORDING TO
 THE RECORDED MAP OR PLATT THEREOF.

Robert G. Anderson

ROBERT G. ANDERSON
 6/2/69

Homer D. Ralph, Jr.

HOMER D. RALPH JR.
 SURVEYOR FOR GRANT CO., WIS.
 WIS. REG. NO. S-141

