


DECHOW SURVEY

Scale: 1" = 50'

o 1" X 24" Iron pipe placed by this survey.

— x — x — Existing fence.

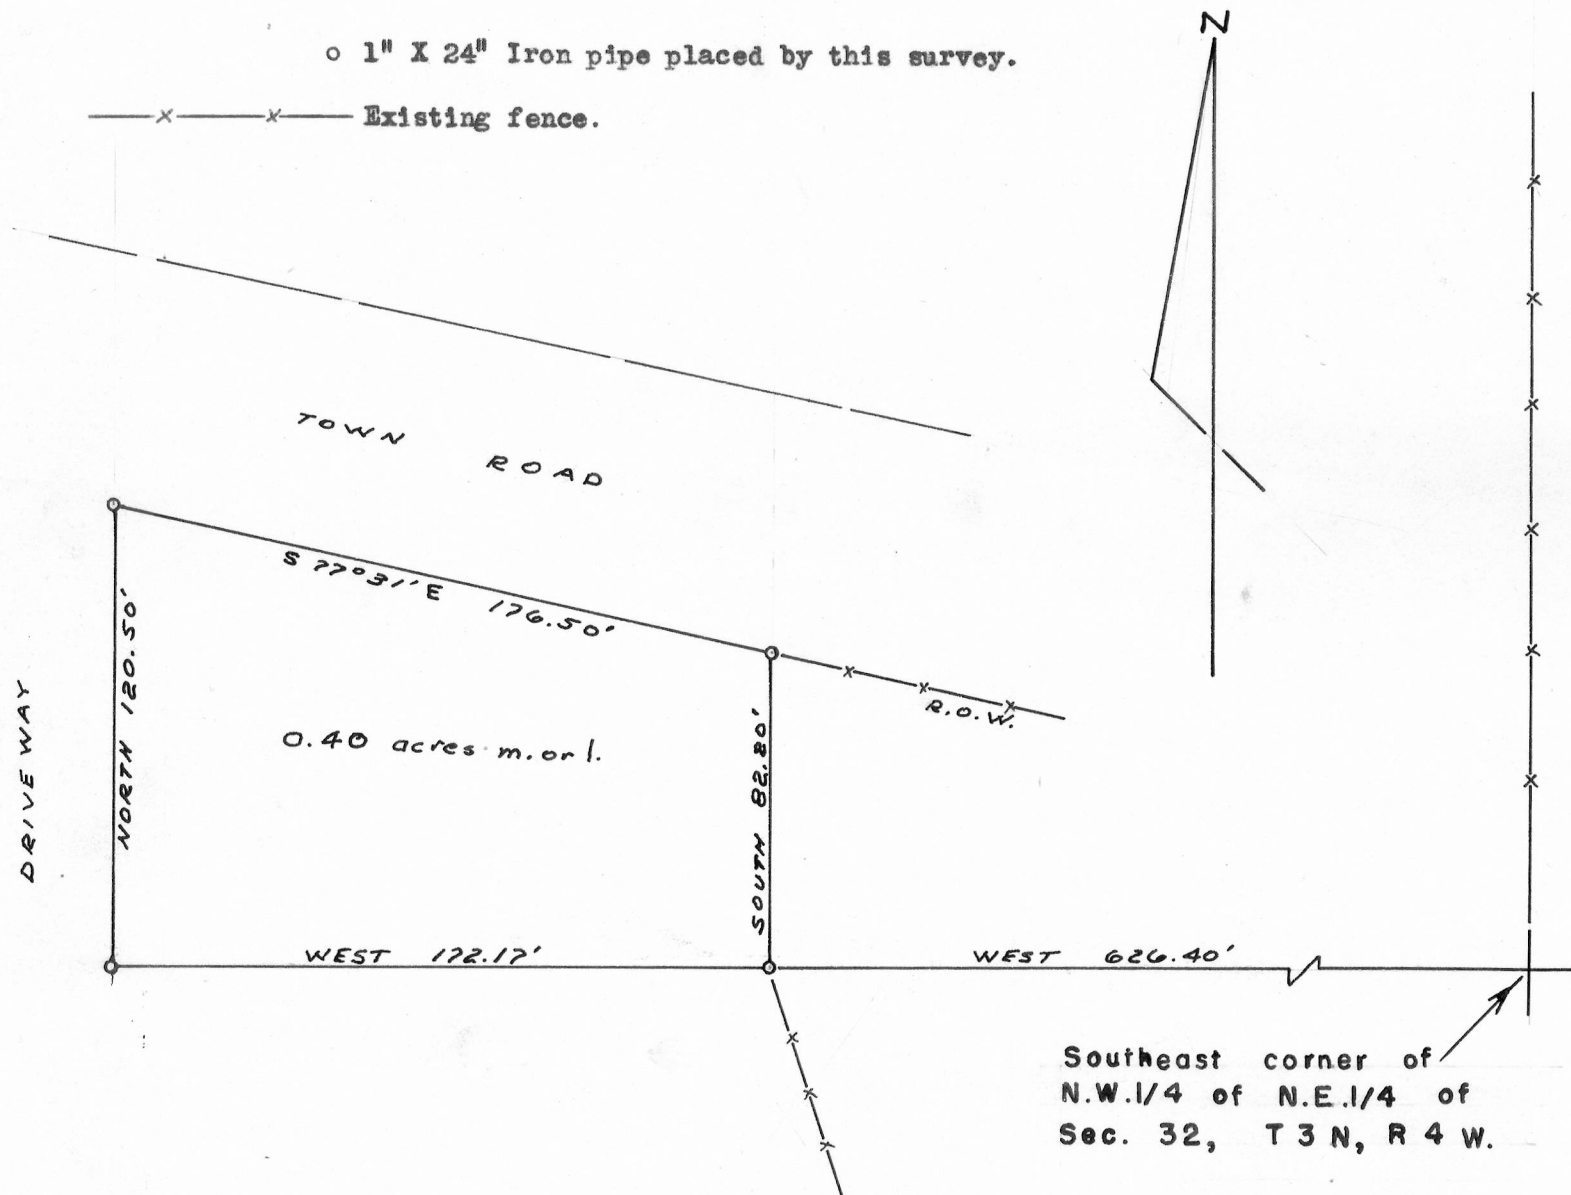


DESCRIPTION:

A part of the N.W. 1/4 of N.E. 1/4 of Section 32, T 3 N, R 4 W of the 4th P.M.,

Grant County, Wisconsin described as follows, to-wit:

Begin at a point which is 626.40 feet West of the Southeast corner of the N.W. 1/4 of N.E. 1/4 of said Section 32; thence West 172.17 feet; thence North 120.50 feet; thence South 77° 31' East 176.50 feet; thence South 82.20 feet to the place of beginning. Containing 0.40 acres more or less.

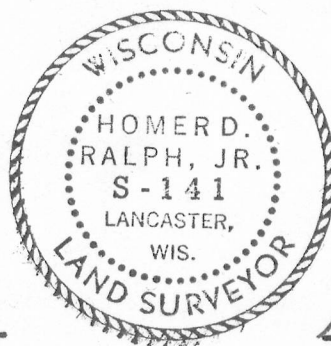

Charles Lange
Charles Lange
8/3 - 8/17/72

Homer D. Ralph, Jr.
Homer D. Ralph, Jr.
Surveyor for Grant
County, Wisconsin.