


N.W. corner
N.E.1/4, N.W.1/4
Sec. 13-4-4

LAUFENBERG SURVEY

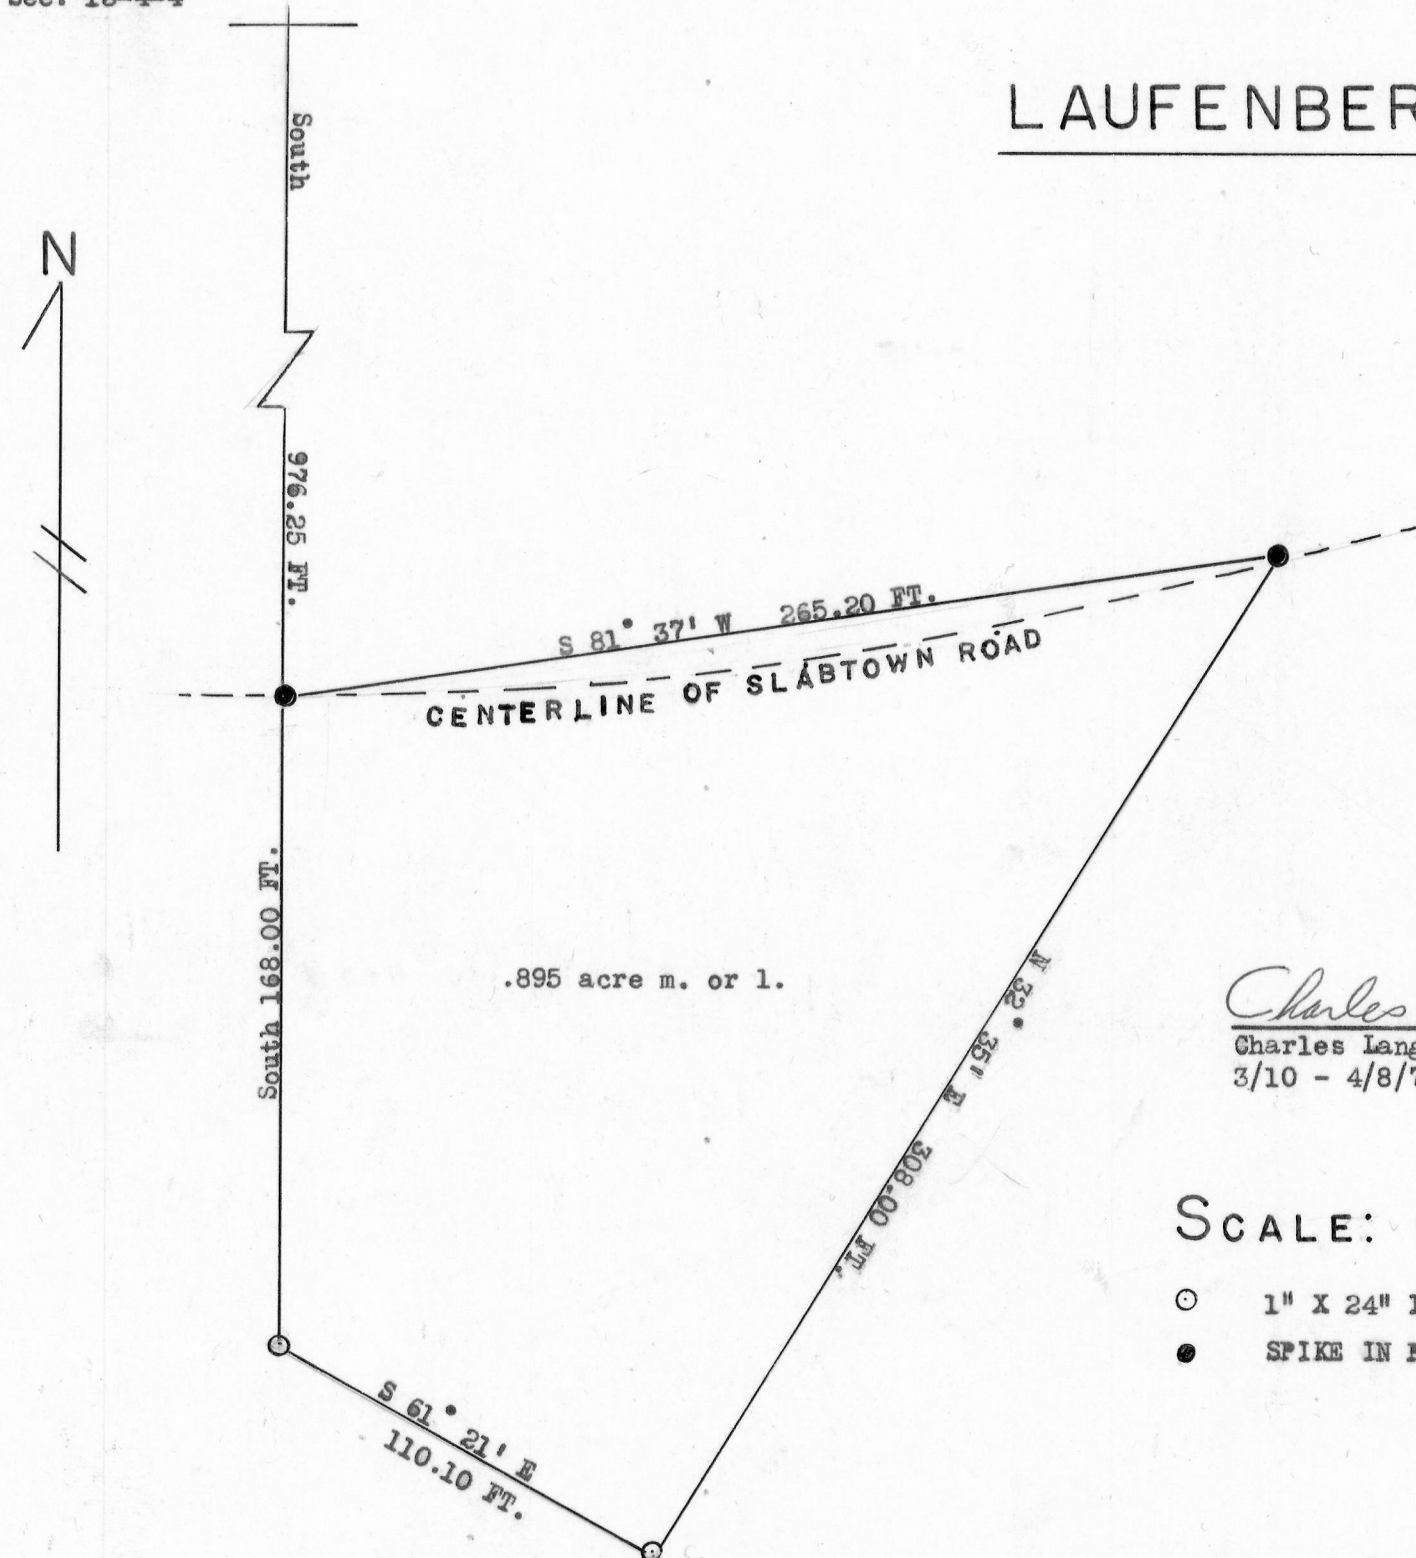

DESCRIPTION

A part of the N.E.1/4 of the N.W.1/4 of Section 13, T 4 N, R 4 W, of the 4th P.M., Grant County, Wisconsin described as follows, to-wit: Beginning at a point on the centerline of the Slabtown Road, which is 976.25 feet South of the Northwest corner of said N.E.1/4 of N.W.1/4; thence North 81° 37' East 265.20 feet along the chord of a curve of the centerline of said Road; thence South 32° 35' West 308.00 feet; thence North 61° 21' West 110.10 feet; thence North 168.00 feet to the place of beginning. Containing .895 acres, more or less.

Charles Lange
Charles Lange
3/10 - 4/8/71

SCALE: 1" = 50'

- 1" X 24" IRON PIPE PLACED BY THIS SURVEY
- SPIKE IN PAVEMENT PLACED BY THIS SURVEY

Homer D. Ralph, Jr.
Homer D. Ralph, Jr.
Surveyor for Grant
County, Wisconsin

