


PASCOE SURVEY

SCALE 1" = 50'

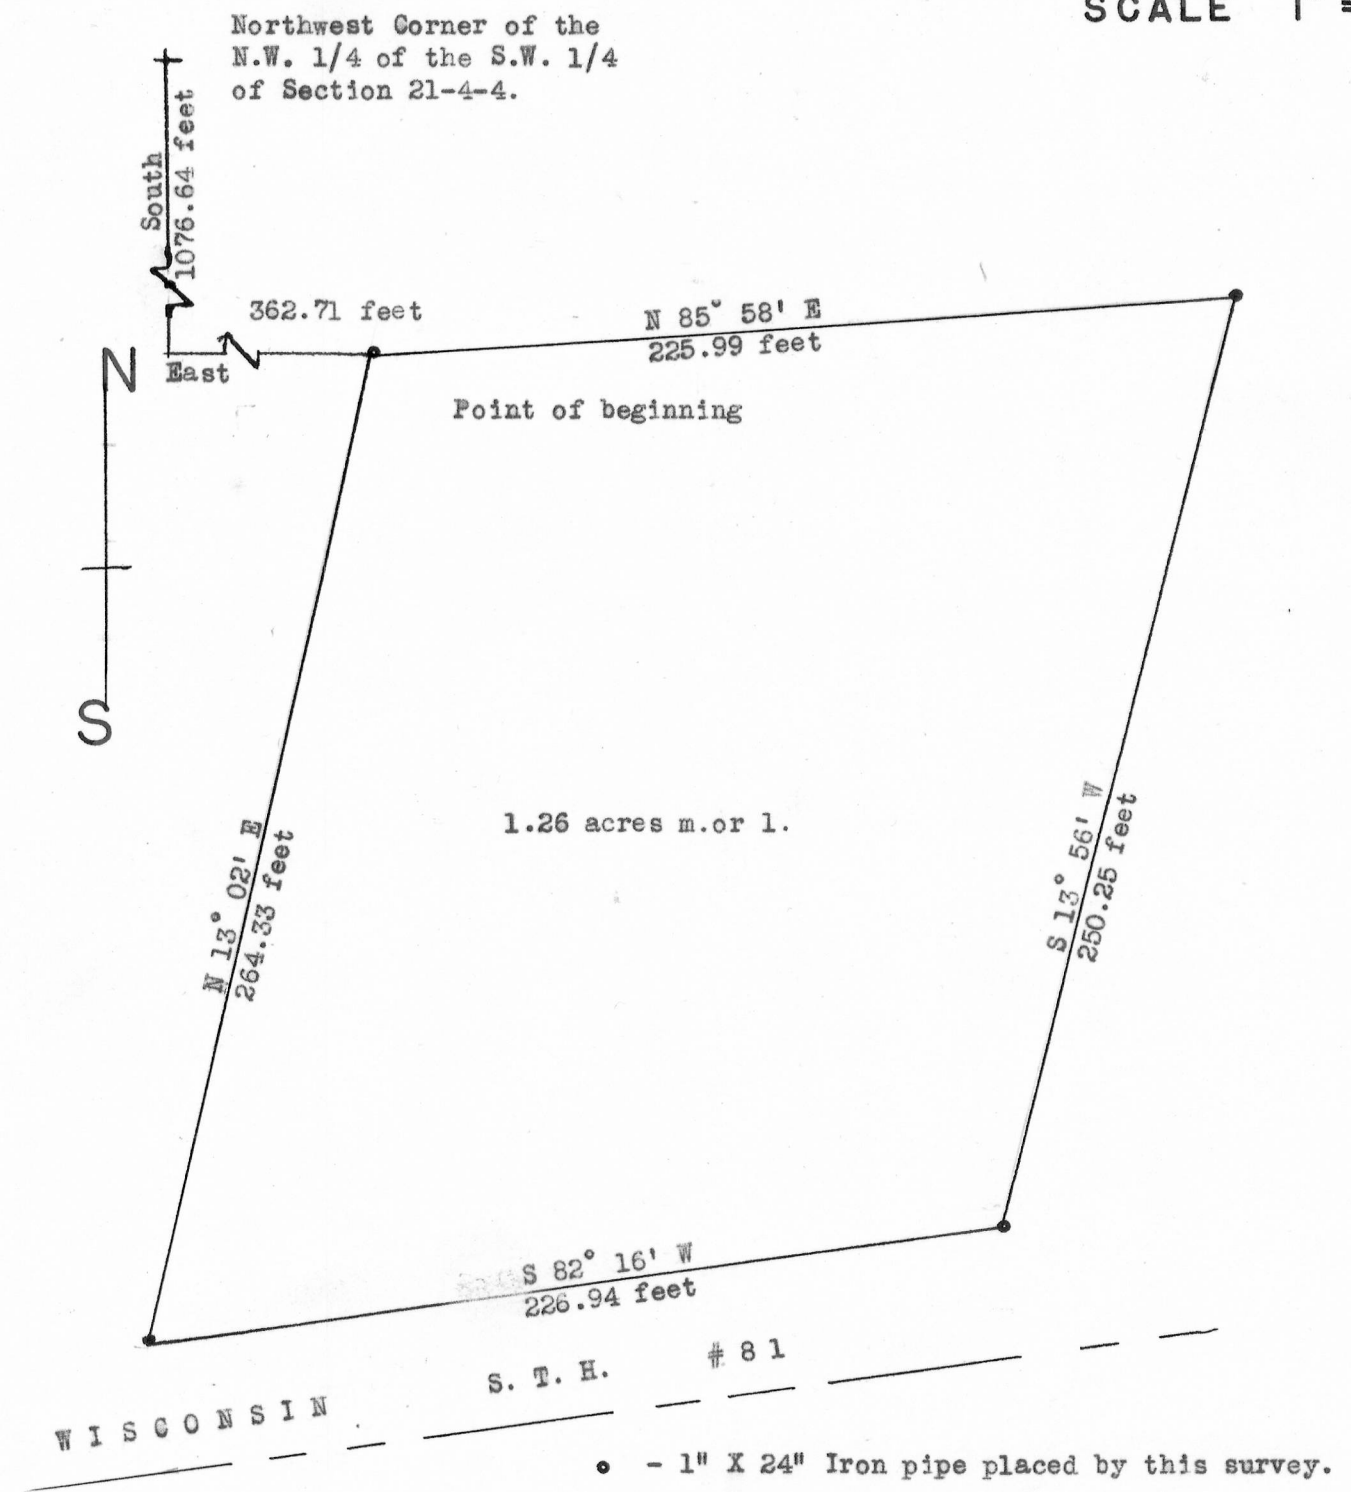

DESCRIPTION:

A part of the N.W. 1/4 of the S.W. 1/4 of Section 21, T 4 N, R 4 W, of the 4th P.M., Grant County, Wisconsin, described as follows to-wit:
Begin at a point which is 1076.64 feet South and 362.71 feet East of the Northwest Corner of the N.W. 1/4 of the S.W. 1/4 of said Section 21; thence North 85° 58' East 225.99 feet; thence South 13° 56' West 250.25 feet to the Northerly boundary of Wisconsin S.T.H. #81; thence South 82° 16' West 226.94 feet along the Northerly boundary of Wisconsin S.T.H. #81; thence North 13° 02' East 264.33 feet to the point of beginning. Containing 1.26 acres more or less.



Ralph Bourret
Ralph Bourret
6/21-6/29/73

Homer D. Ralph, Jr.
Homer D. Ralph, Jr.
Surveyor for Grant
County, Wisconsin.