


PAFFORD SURVEY

NORTH QUARTER CORNER
SECTION 26, T4N, R4W.

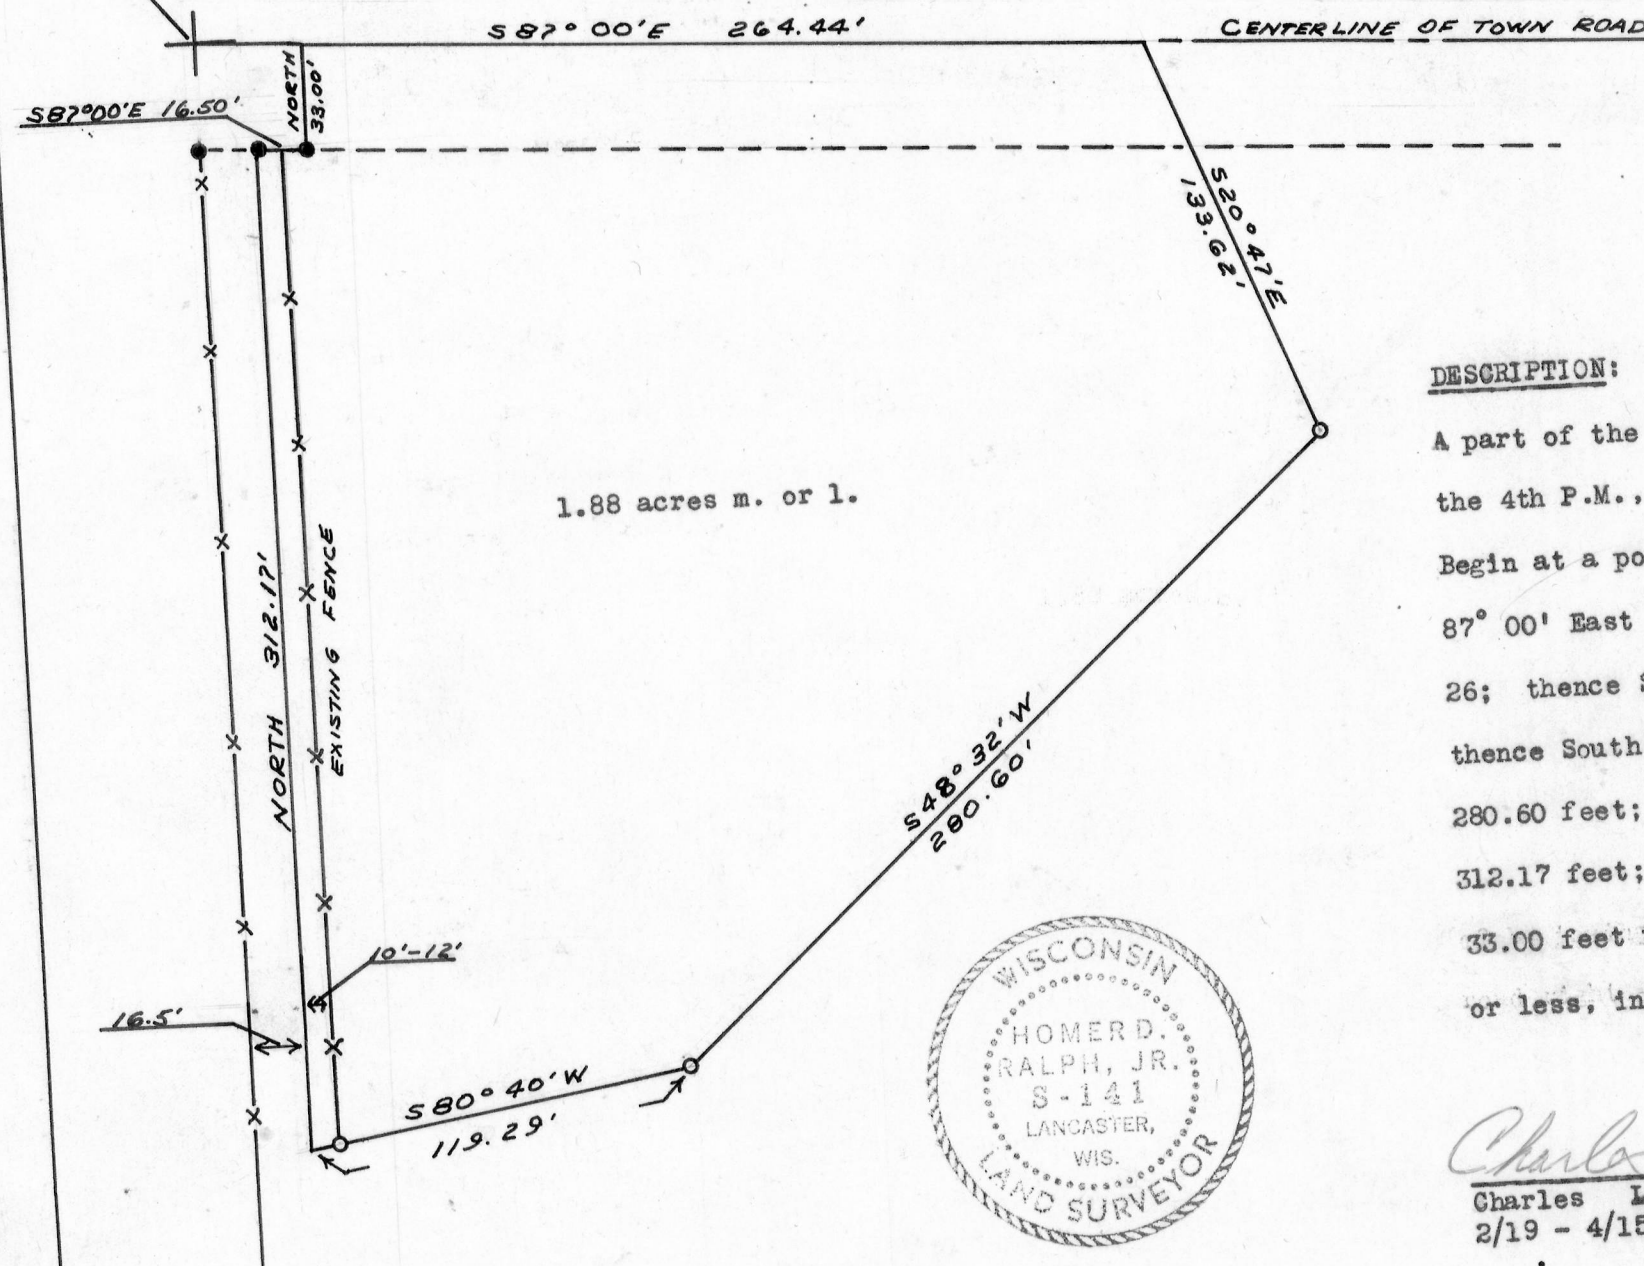


SCALE: 1" = 60'

- 1" X 24" Iron pipe placed by this survey.
- 1" X 24" Iron pipe placed by previous survey.

DESCRIPTION:

A part of the N.W.1/4 of the N.E.1/4 of Section 26, T 4 N, R 4 W. of the 4th P.M., Grant County, Wisconsin, described as follows, to-wit: Begin at a point on the centerline of the town road which is South 87° 00' East 33.00 feet from the North Quarter corner of said Section 26; thence South 87° 00' East 264.44 feet along said centerline; thence South 20° 47' East 133.62 feet; thence South 48° 32' West 280.60 feet; thence South 80° 40' West 119.29 feet; thence North 312.17 feet; thence South 87° 00' East 16.50 feet; thence North 33.00 feet to the place of beginning. Containing 1.88 acres more or less, inclusive of road right-of-way.

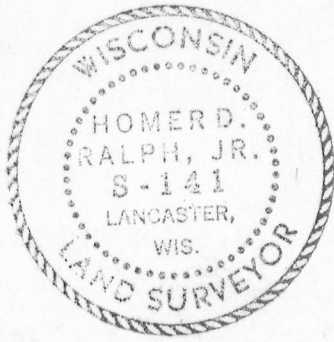

Charles Lange
Charles Lange
2/19 - 4/15/72

Homer D. Ralph, Jr.
Homer D. Ralph, Jr.
Surveyor for Grant
County, Wisconsin.

SCALE: 1" = 60'