



DUNCAN SURVEY

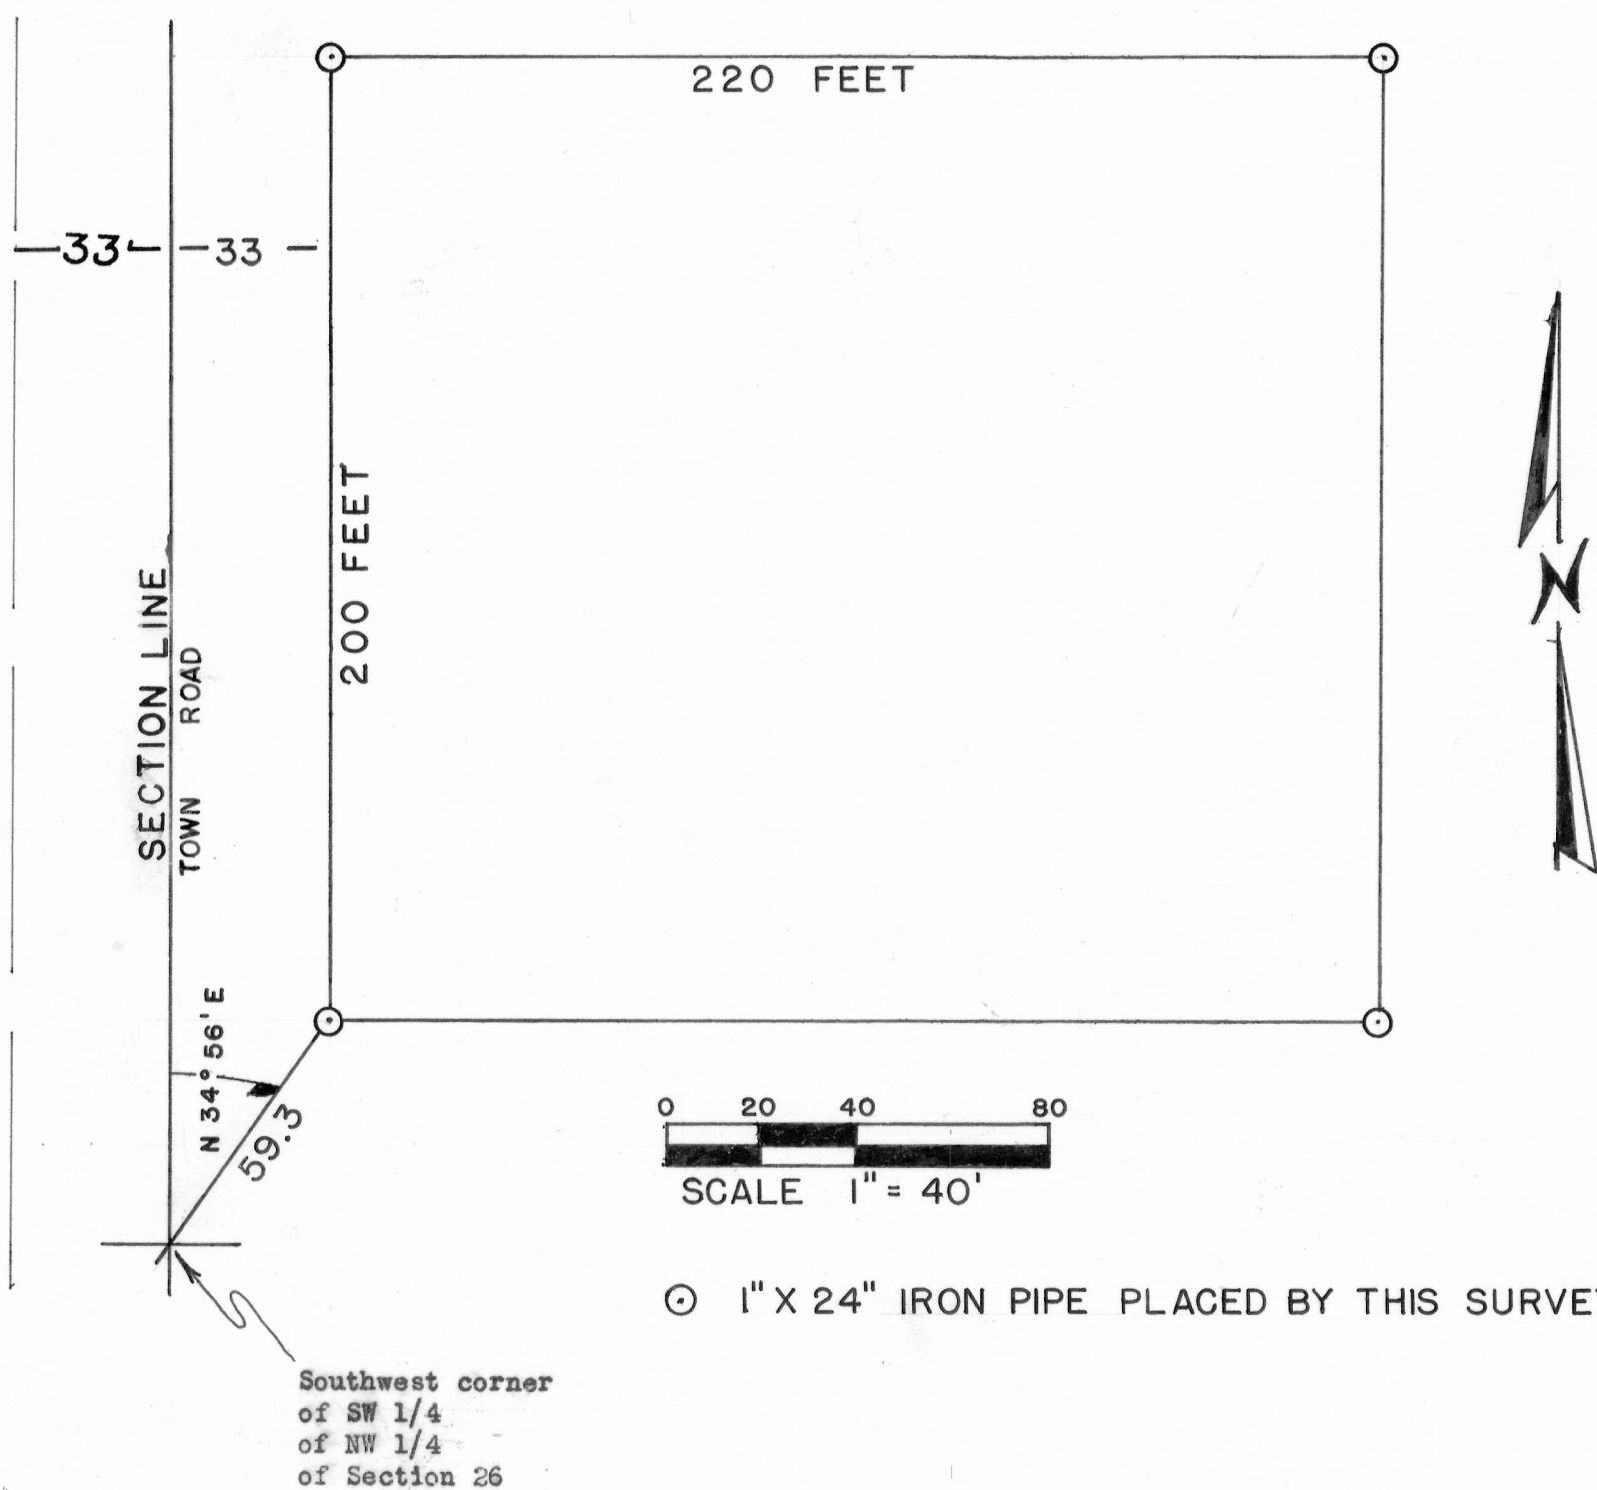

DESCRIPTION

A part of the S.W. 1/4 of the N.W. 1/4 of Section 26, T4N, R4W of the 4th P.M., Grant County, Wisconsin, described as follows, to-wit: Begin at a point which is the ^{SW corner} S.W. 1/4 of the N.W. 1/4 of Section 26; thence North 34° 56' East 59.3 feet to point of beginning; thence East 220 feet; thence North 200 feet; thence West 220 feet; thence South 200 feet to point of beginning.

Art Seymour
Art Seymour
6/11/69

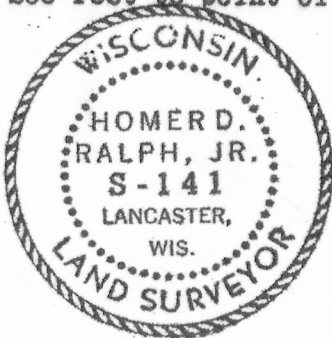

Homer D. Ralph, Jr.
Homer D. Ralph, Jr.
Surveyor for Grant Co., Wis.