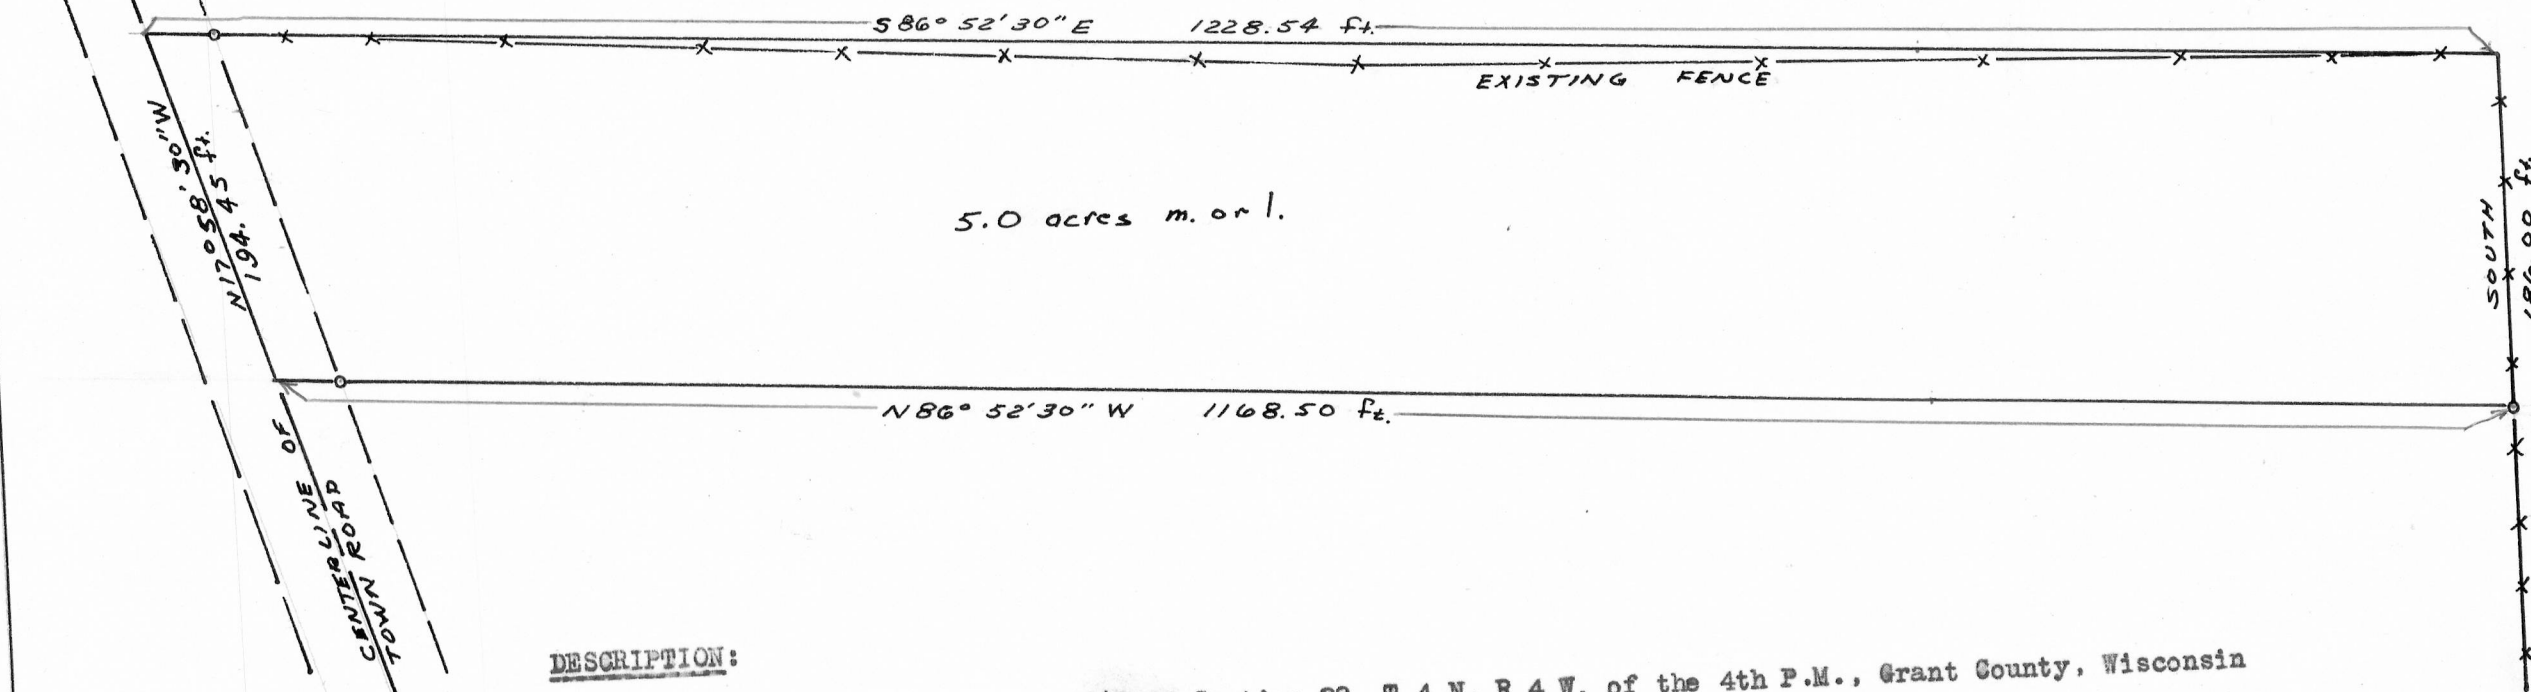


SLAUGHT

SURVEY

SCALE: 1"=100'

o 1" X 24" Iron pipe placed by this survey.

Northeast corner of
Section 29 T4N, R4W.DESCRIPTION:

A part of the N.E.1/4 of the N.E.1/4 of Section 29, T 4 N, R 4 W. of the 4th P.M., Grant County, Wisconsin

described as follows to-wit:

Begin at the Northeast corner of said Section 29; thence South 181.69 feet; thence North 86° 52' 30" West 1168.50 feet to the centerline of town road; thence North 17° 58' 30" West 194.45 feet along said centerline; thence South 86° 52' 30" East 1228.54 feet to the place of beginning. Containing 5.0 acres more or less.

Charles Lange
Charles Lange
9/19 - 10/19/72



Homer D. Ralph, Jr.
Homer D. Ralph, Jr.
Surveyor for Grant
County, Wisconsin.