
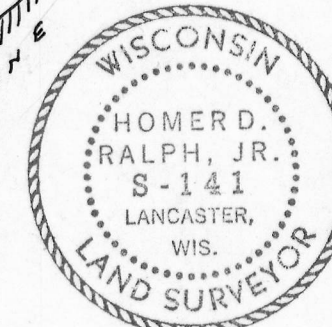


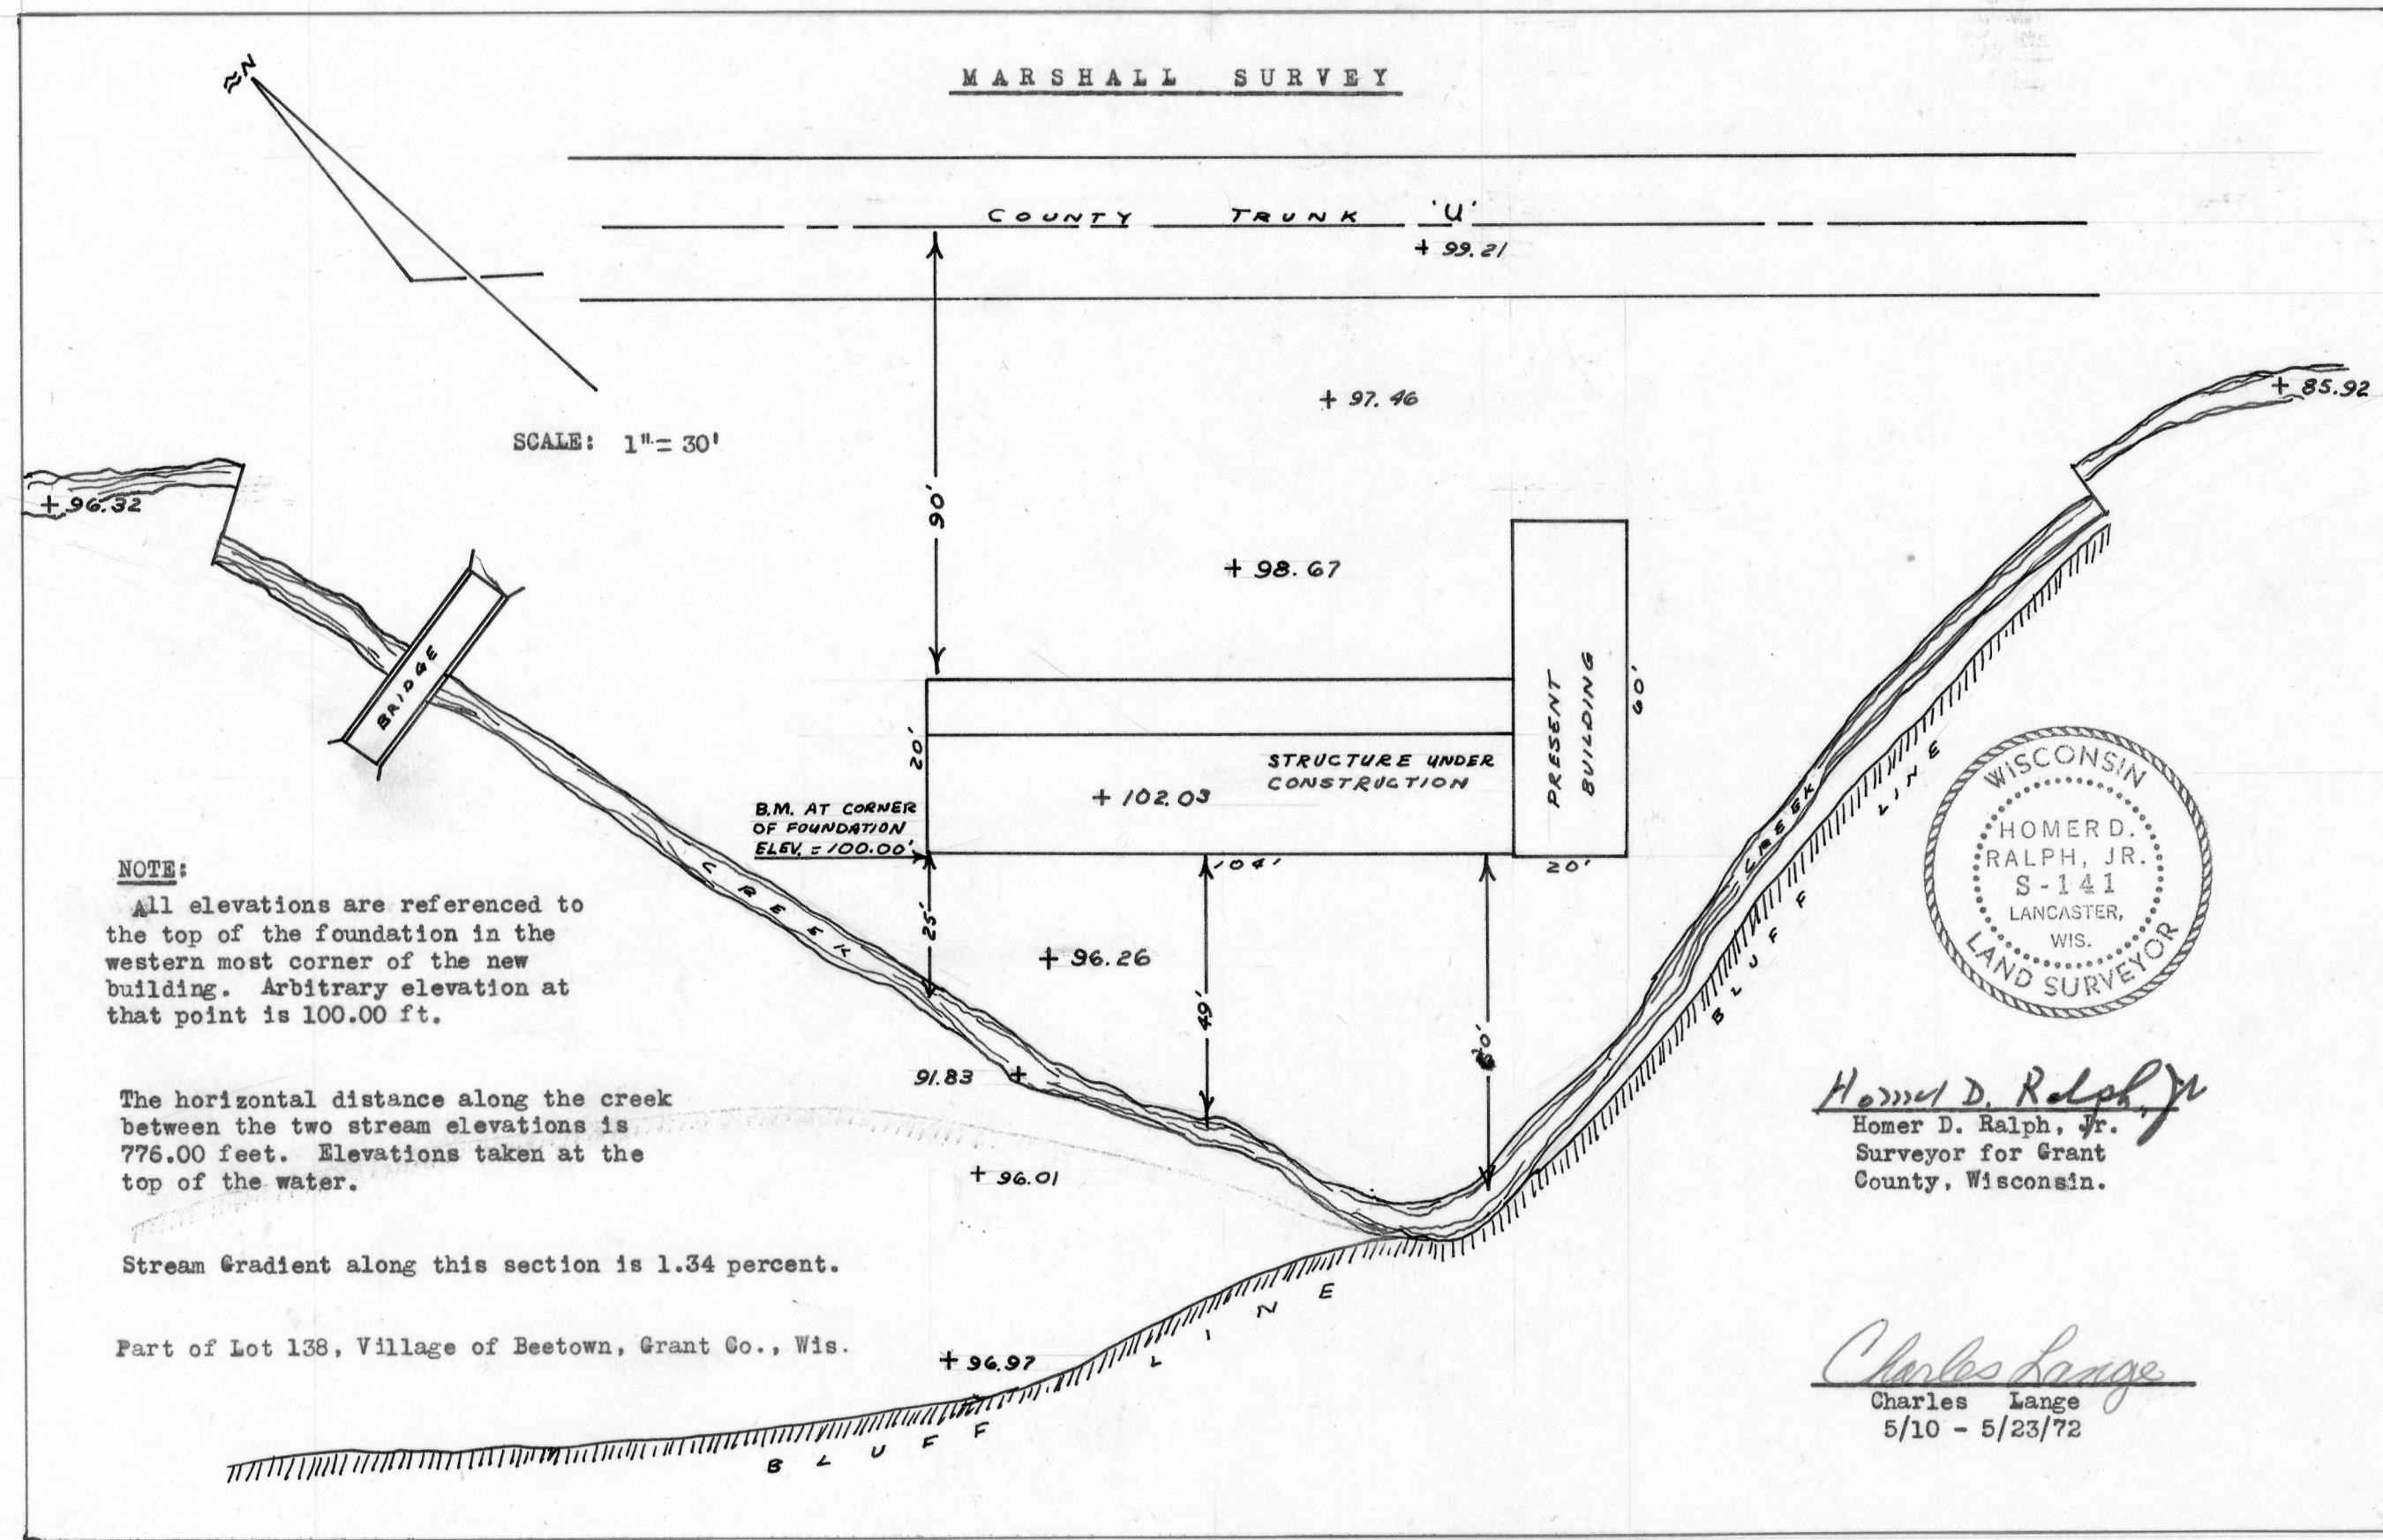

Homer D. Ralph, Jr.
Homer D. Ralph, Jr.
Surveyor for Grant
County, Wisconsin.

Charles Lange
Charles Lange
5/10 - 5/23/72