


METCALF SURVEY

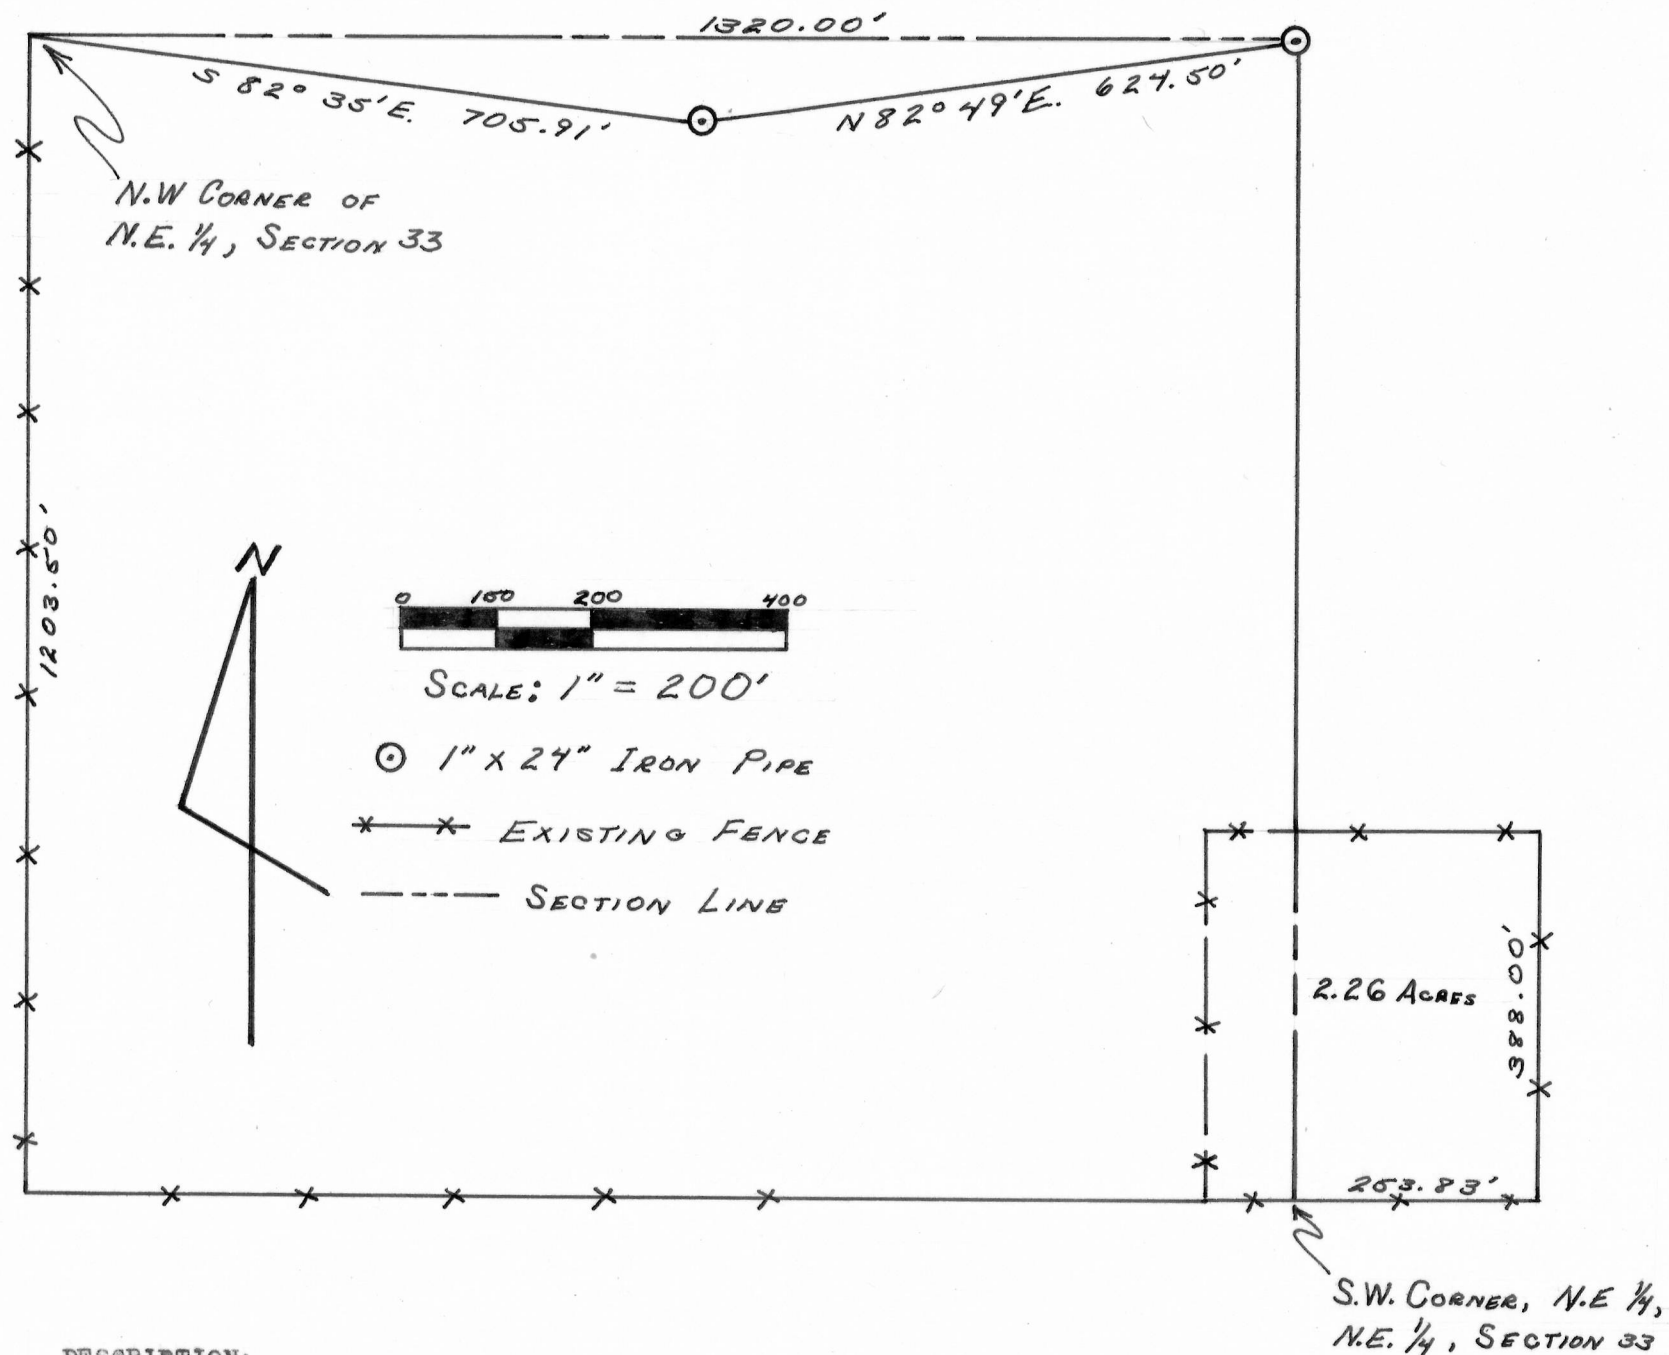

DESCRIPTION:

The N.W. 1/4 of N.E. 1/4 of Section 33, T 4 N, R 4 W. of 4th P.M., Grant County, Wisconsin.

EXCEPT beginning at the Northwest corner of said tract; thence East 1320 feet;

thence South 82° 49' West 624.50 feet; thence North 82° 35' West 705.91 feet

to the place of beginning.


Also including part of the S.W. 1/4 of N.E. 1/4 of N.E. 1/4 of said Section 33

described as follows, to-wit: Begin at the Southwest corner of said N.E. 1/4

of N.E. 1/4; thence East 253.83 feet; thence North 388.00 feet; thence West

253.83 feet; thence South 388.00 feet to the place of beginning.

Containing 40 acres, more or less.

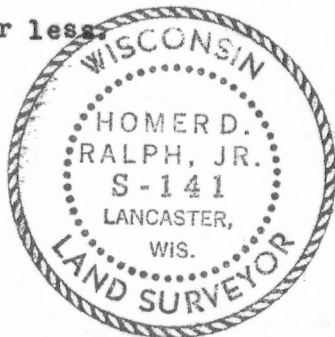

Homer D. Ralph, Jr.
Homer D. Ralph, Jr.
Surveyor for Grant Co., Wis.