



RUD KUSSMAUL SURVEY

SCALE: 1" = 100'

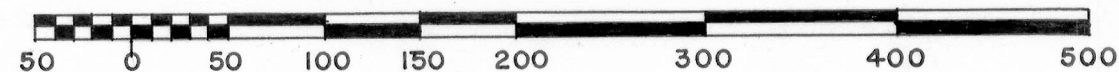

N

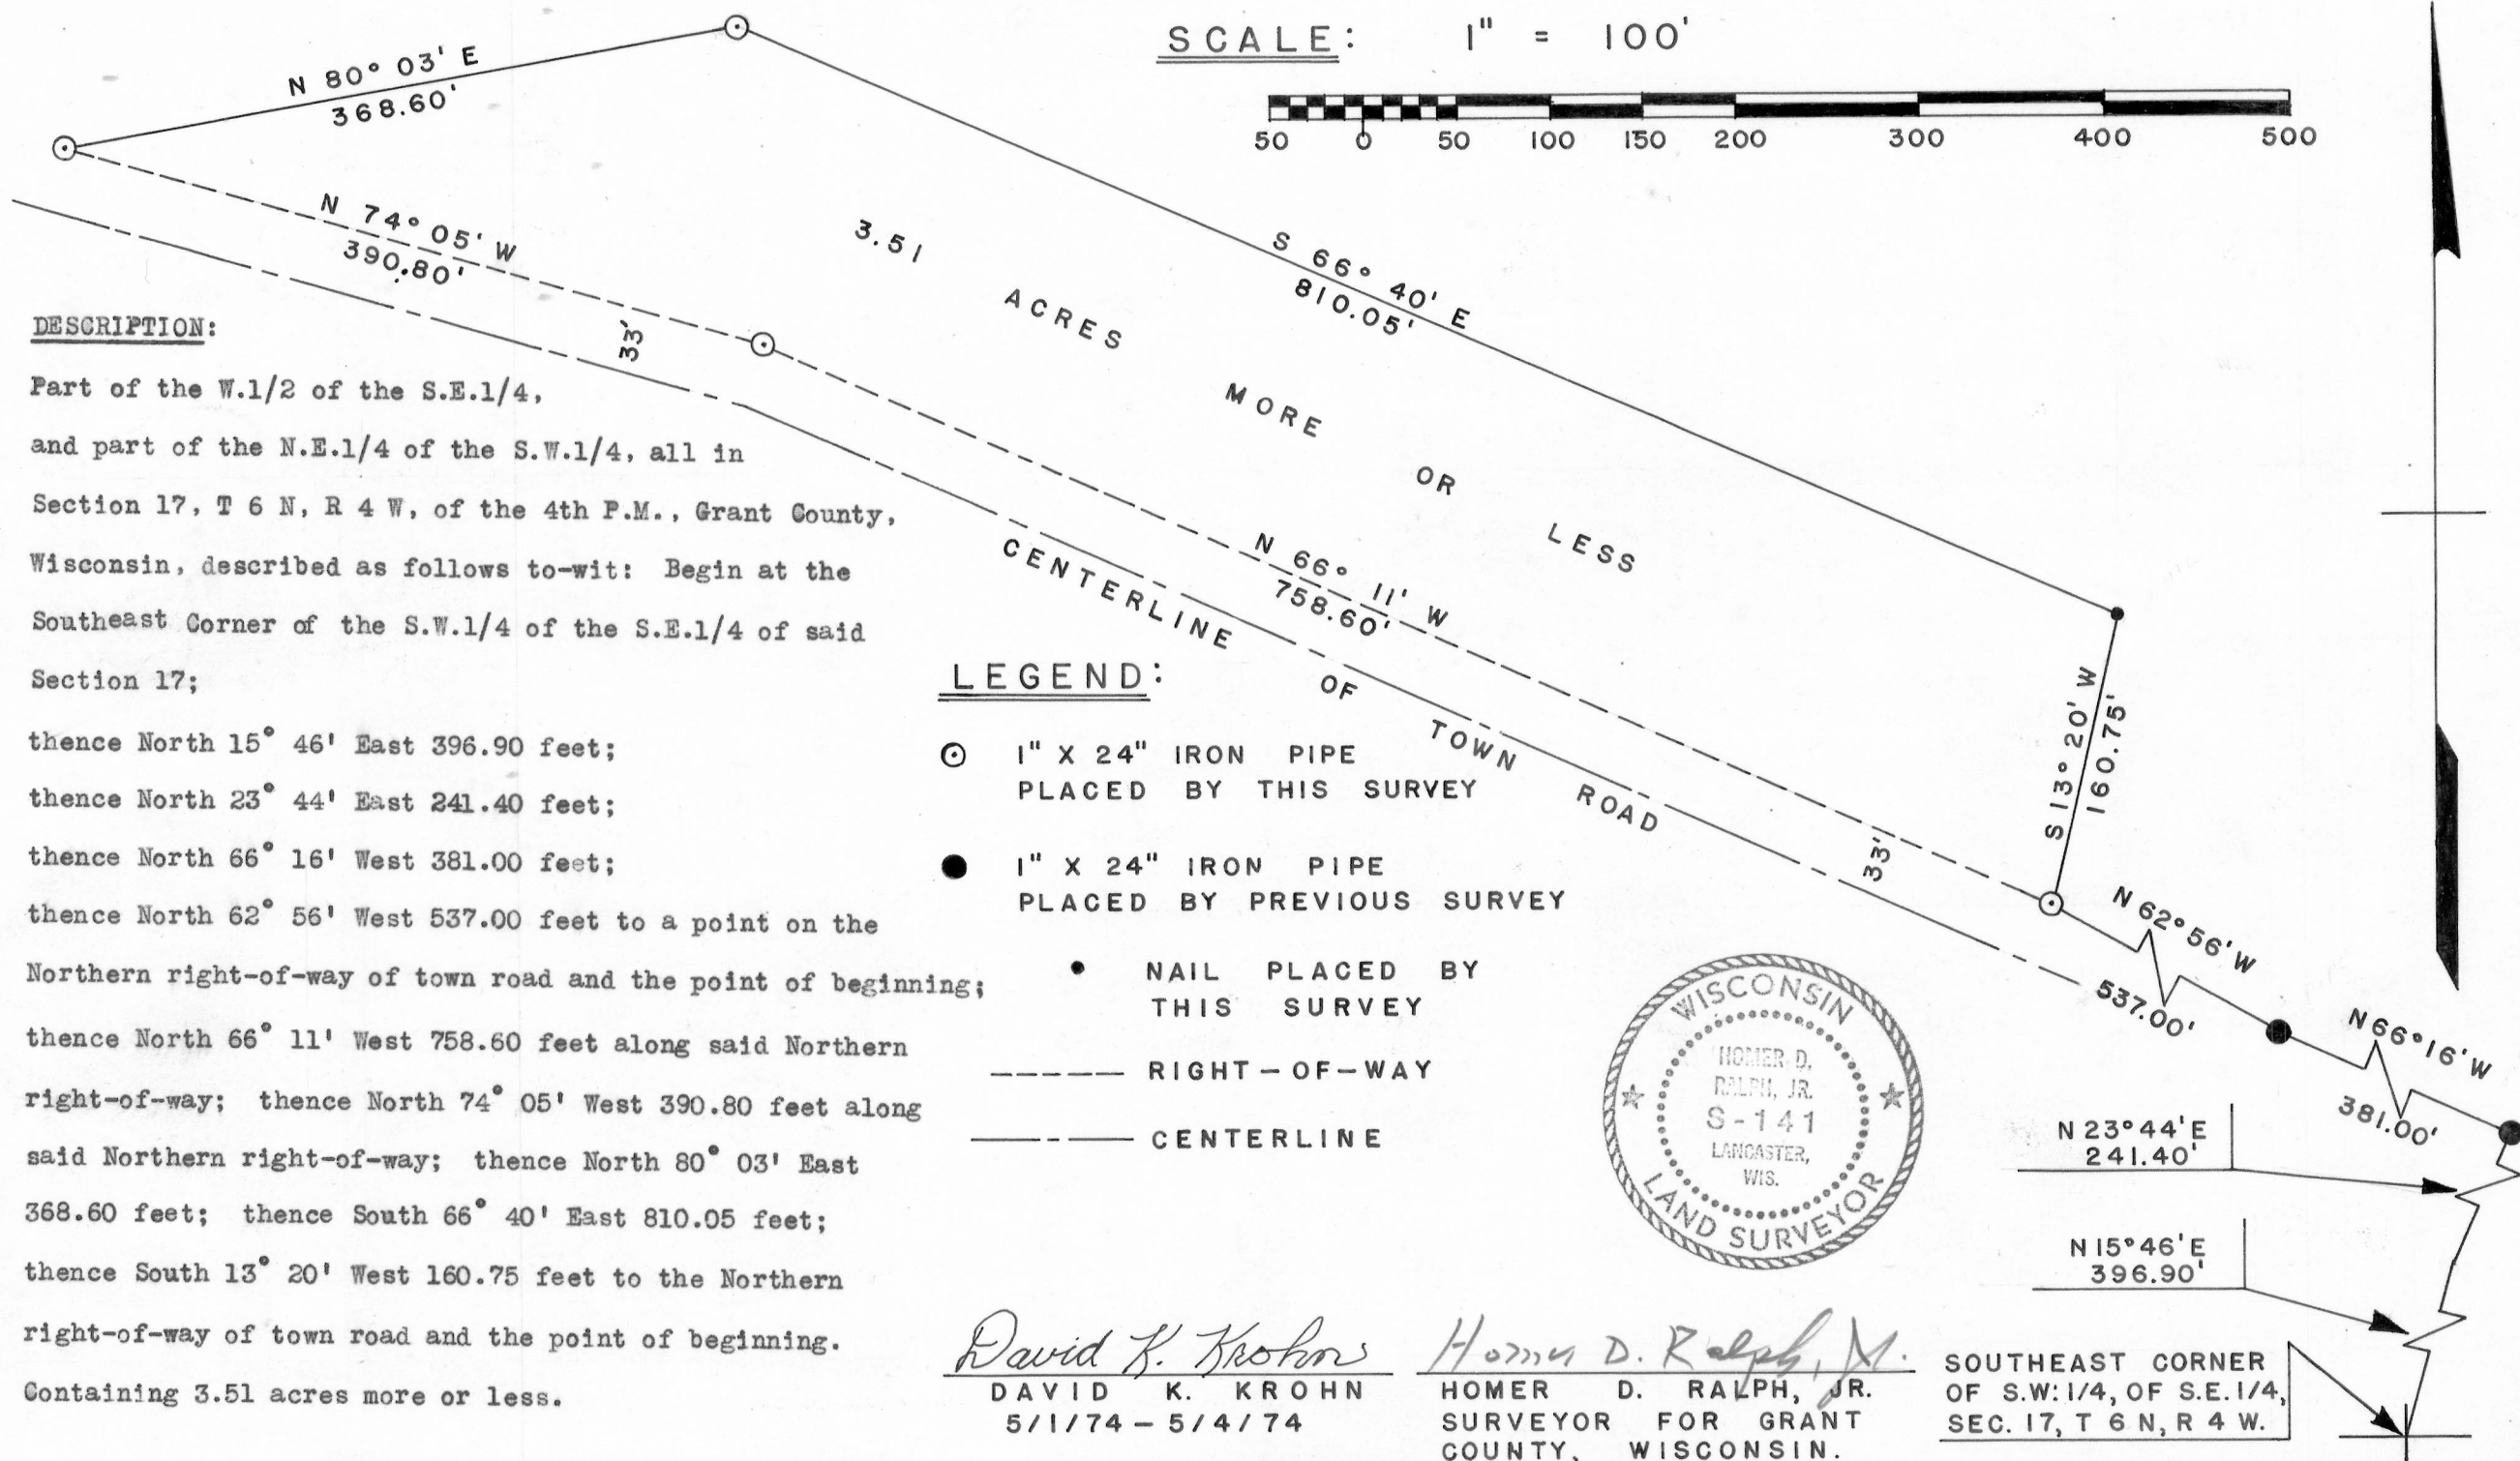


DESCRIPTION:

Part of the W.1/2 of the S.E.1/4,
and part of the N.E.1/4 of the S.W.1/4, all in
Section 17, T 6 N, R 4 W, of the 4th P.M., Grant County,
Wisconsin, described as follows to-wit: Begin at the
Southeast Corner of the S.W.1/4 of the S.E.1/4 of said
Section 17;
thence North 15° 46' East 396.90 feet;
thence North 23° 44' East 241.40 feet;
thence North 66° 16' West 381.00 feet;
thence North 62° 56' West 537.00 feet to a point on the
Northern right-of-way of town road and the point of beginning;
thence North 66° 11' West 758.60 feet along said Northern
right-of-way; thence North 74° 05' West 390.80 feet along
said Northern right-of-way; thence North 80° 03' East
368.60 feet; thence South 66° 40' East 810.05 feet;
thence South 13° 20' West 160.75 feet to the Northern
right-of-way of town road and the point of beginning.
Containing 3.51 acres more or less.

LEGEND:

- 1" X 24" IRON PIPE
PLACED BY THIS SURVEY
- 1" X 24" IRON PIPE
PLACED BY PREVIOUS SURVEY
- NAIL PLACED BY
THIS SURVEY
- RIGHT-OF-WAY
- CENTERLINE

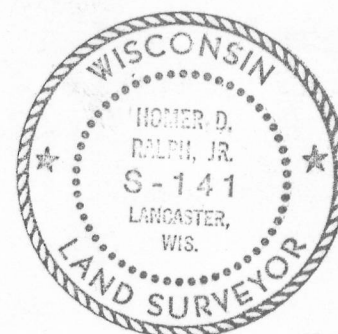

David K. Krohn
DAVID K. KROHN
5/1/74 - 5/4/74

Homer D. Ralph, Jr.
HOMER D. RALPH, JR.
SURVEYOR FOR GRANT
COUNTY, WISCONSIN.

SOUTHEAST CORNER
OF S.W. 1/4, OF S.E. 1/4,
SEC. 17, T 6 N, R 4 W.