


SCHMITZ SURVEY

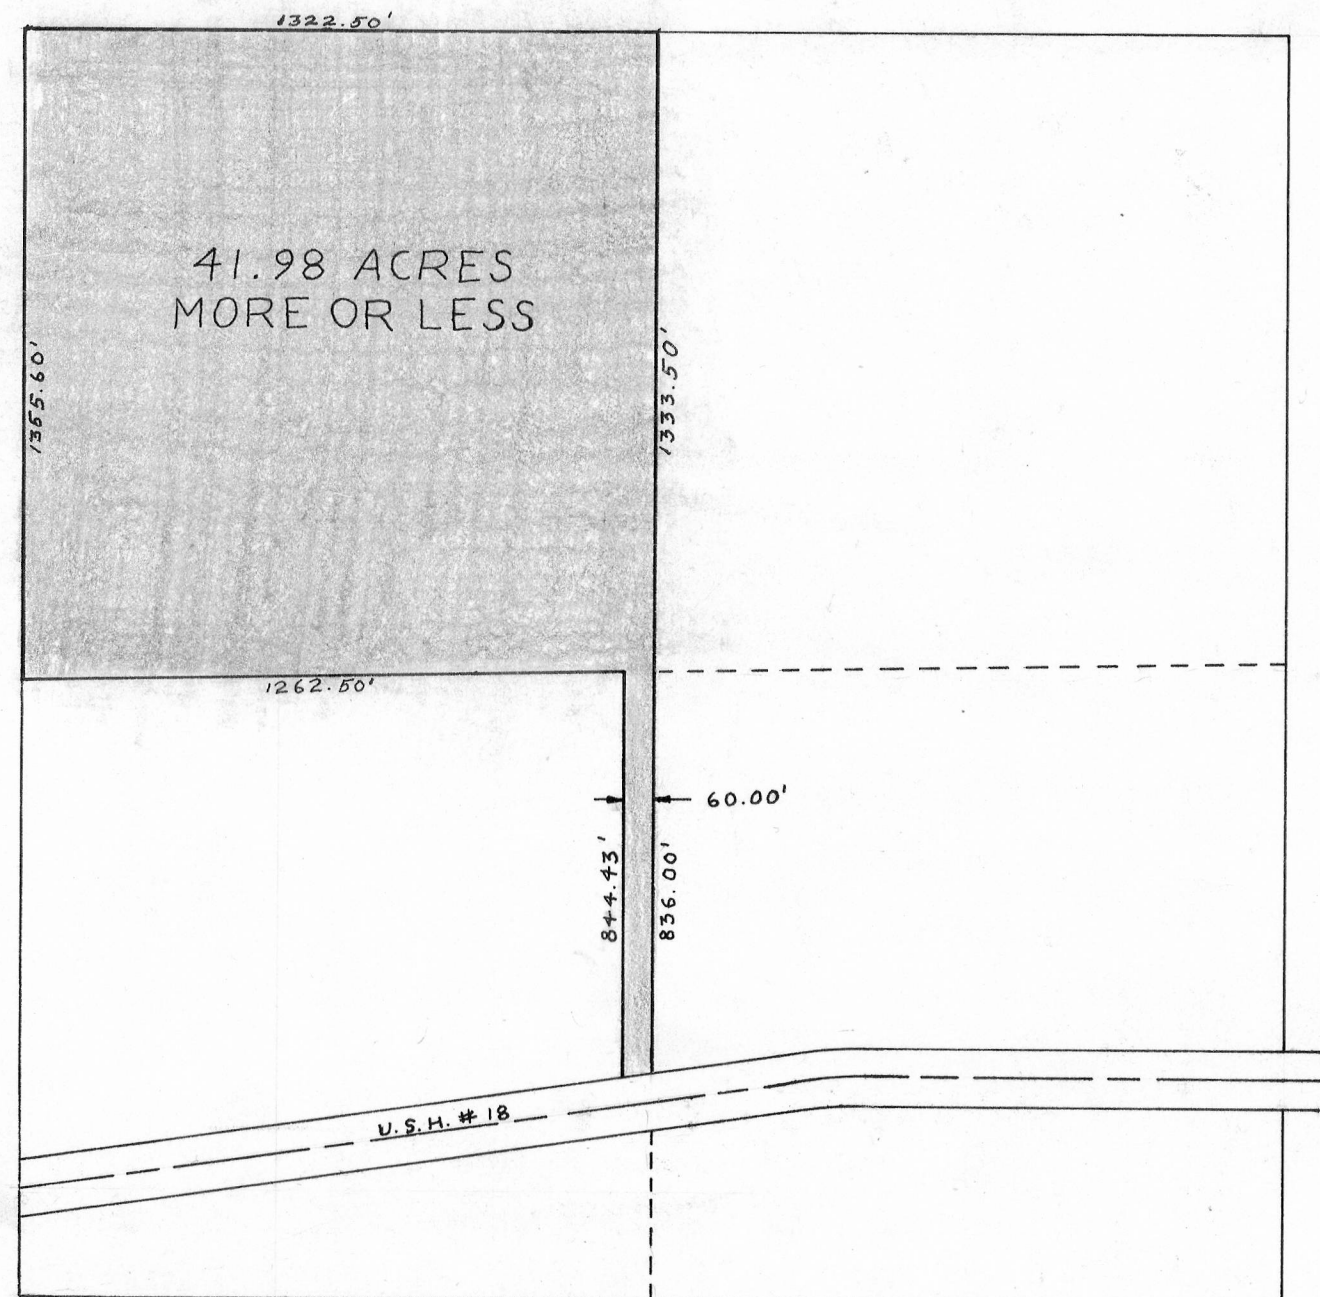


S.E. 1/4 of Section 23, T 6 N, R 4 W


DESCRIPTION

The Northwest 1/4 of the Southeast 1/4 of Section 23, T 6 N, R 4 W, of the 4th P.M., Grant County, Wisconsin.

Also the East 60.00 feet of the S.W. 1/4 of S.E. 1/4 of said Section 23 lying north of U.S. Highway # 18.

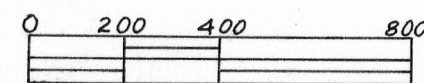

SCALE: 1" = 400'

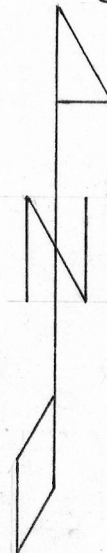

John F. Elwell
JOHN F. ELWELL
4-16-73 ~ 4-19-73

Homer D. Ralph, Jr.
HOMER D. RALPH JR.
SURVEYOR FOR
GRANT COUNTY,
WISCONSIN

