

REIDL SURVEY

David K. Krohn
 DAVID K. KROHN
 1/26/74 - 2/15/74




Homer D. Ralph, Jr.
 HOMER D. RALPH, JR.
 SURVEYOR FOR GRANT
 COUNTY, WISCONSIN.

LEGEND:

- 1" X 24" IRON PIPE PLACED BY THIS SURVEY
- NAIL PLACED ON LINE BY THIS SURVEY

***** FENCE

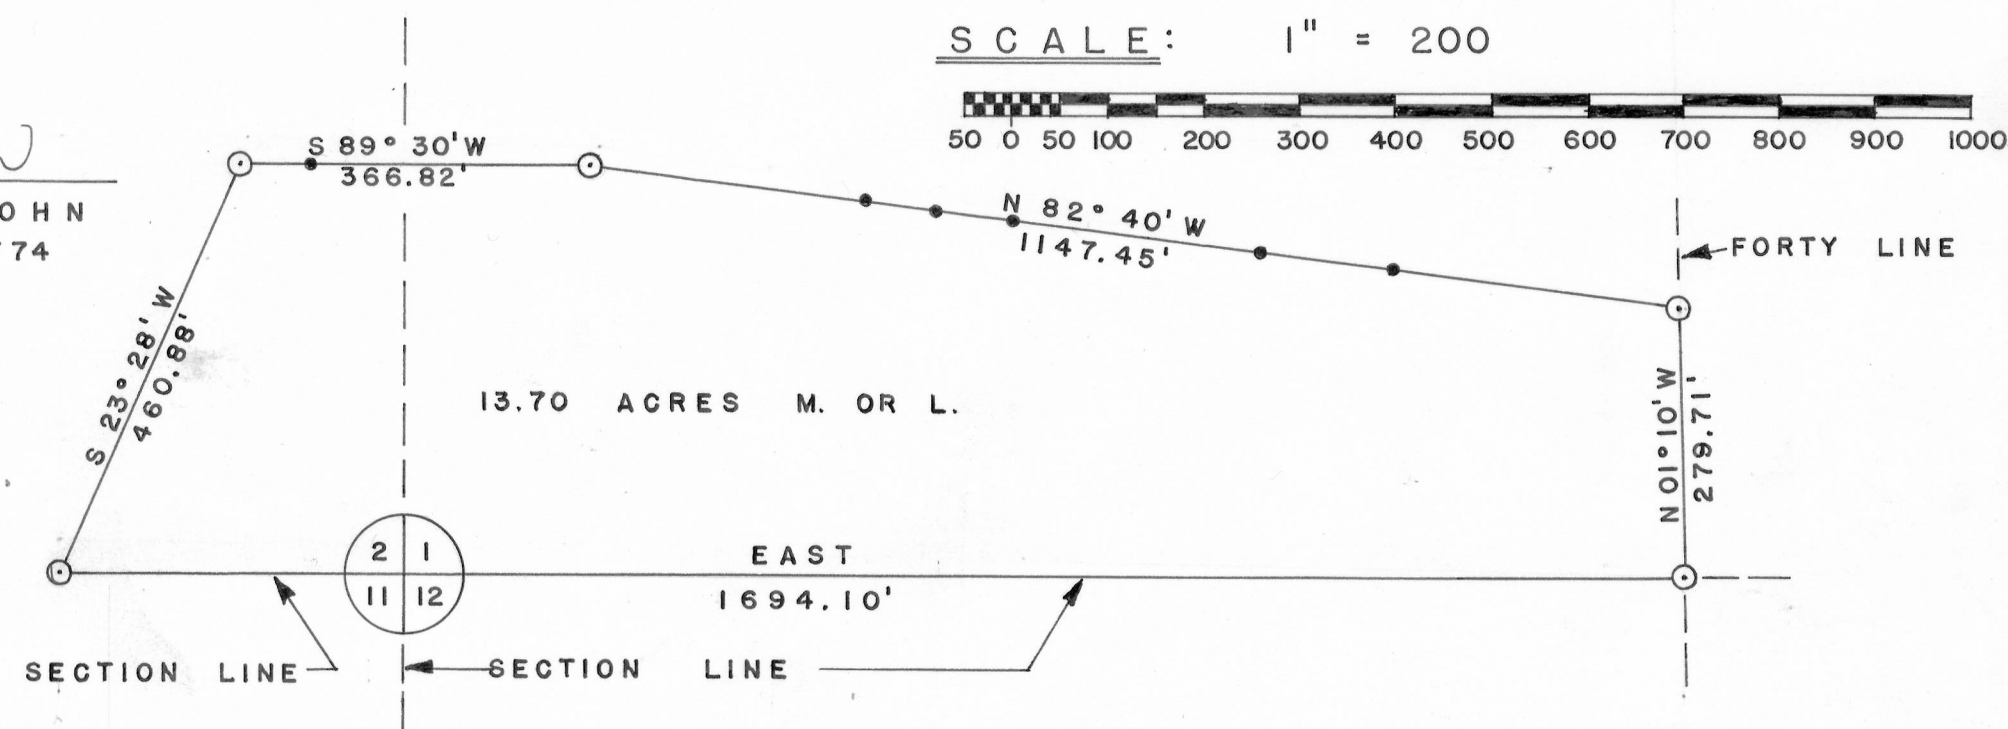

DESCRIPTION:

Part of the S.E.1/4 of S.E.1/4 of Section 2, and part of the S.W.1/4 of S.W.1/4 of Section 1, all in T 3 N, R 5 W, of the 4th P.M., Grant County, Wisconsin, described as follows to-wit:

Begin at the Southeast corner of the S.W.1/4 of S.W.1/4 of said Section 1;

thence North 01° 10' West 279.71 feet along the east line of said forty;

thence North 82° 40' West 1147.45 feet;

thence South 89° 30' West 366.82 feet;

thence South 23° 28' West 460.88 feet to the South line of Section 2;

thence East 1694.10 feet along the South lines of Sections 1 and 2 to the point of beginning.

Containing 13.70 acres more or less.