

BREWER - LORSCHETER SURVEY

NORTHEAST CORNER OF
N.W. 1/4 OF N.W. 1/4 OF
SEC. 15, T 3 N, R 5 W OF
THE 4TH P.M., GRANT
COUNTY, WISCONSIN.

LEGEND:

- 1" X 24" IRON PIPE PLACED BY THIS SURVEY
- NAIL PLACED BY THIS SURVEY
- FENCE

DESCRIPTION:


Part of the N.W.1/4 of the N.W.1/4 of Section 15, T 3 N, R 5 W of the 4th P.M., Grant County, Wisconsin, described as follows to-wit:
Commencing at the Northeast Corner of the N.W.1/4 of the N.W.1/4 of said Section 15; thence South 68° 12' West 647.30 feet; thence South 48° 27' West 522.50 feet to a point on the centerline of State Trunk Highway #81 and the point of beginning; thence South 39° 00' West 355.78 feet along said centerline; thence North 51° 00' West 57.47 feet to a point on the Northwestern right-of-way of said highway; thence North 02° 20' West 324.85 feet; thence South 77° 44' East 248.61 feet to a point on the Northwestern right-of-way of said highway; thence South 51° 00' East 50.00 feet to a point on the centerline of State Trunk Highway #81 and the point of beginning. Containing 1.34 acres more or less inclusive of highway right-of-way.

SCALE: 1" = 60'



1.34 ACRES M. OR L.
INCLUSIVE OF R.O.W.

CENTERLINE OF STATE HIGHWAY NO. 81

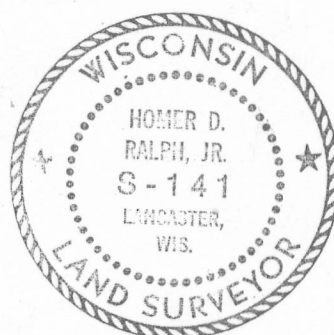

Homer D. Ralph, Jr.
HOMER D. RALPH, JR.
SURVEYOR FOR GRANT
COUNTY, WISCONSIN

David K. Krohn
DAVID K. KROHN
12/13/74 12/19/74

N

