



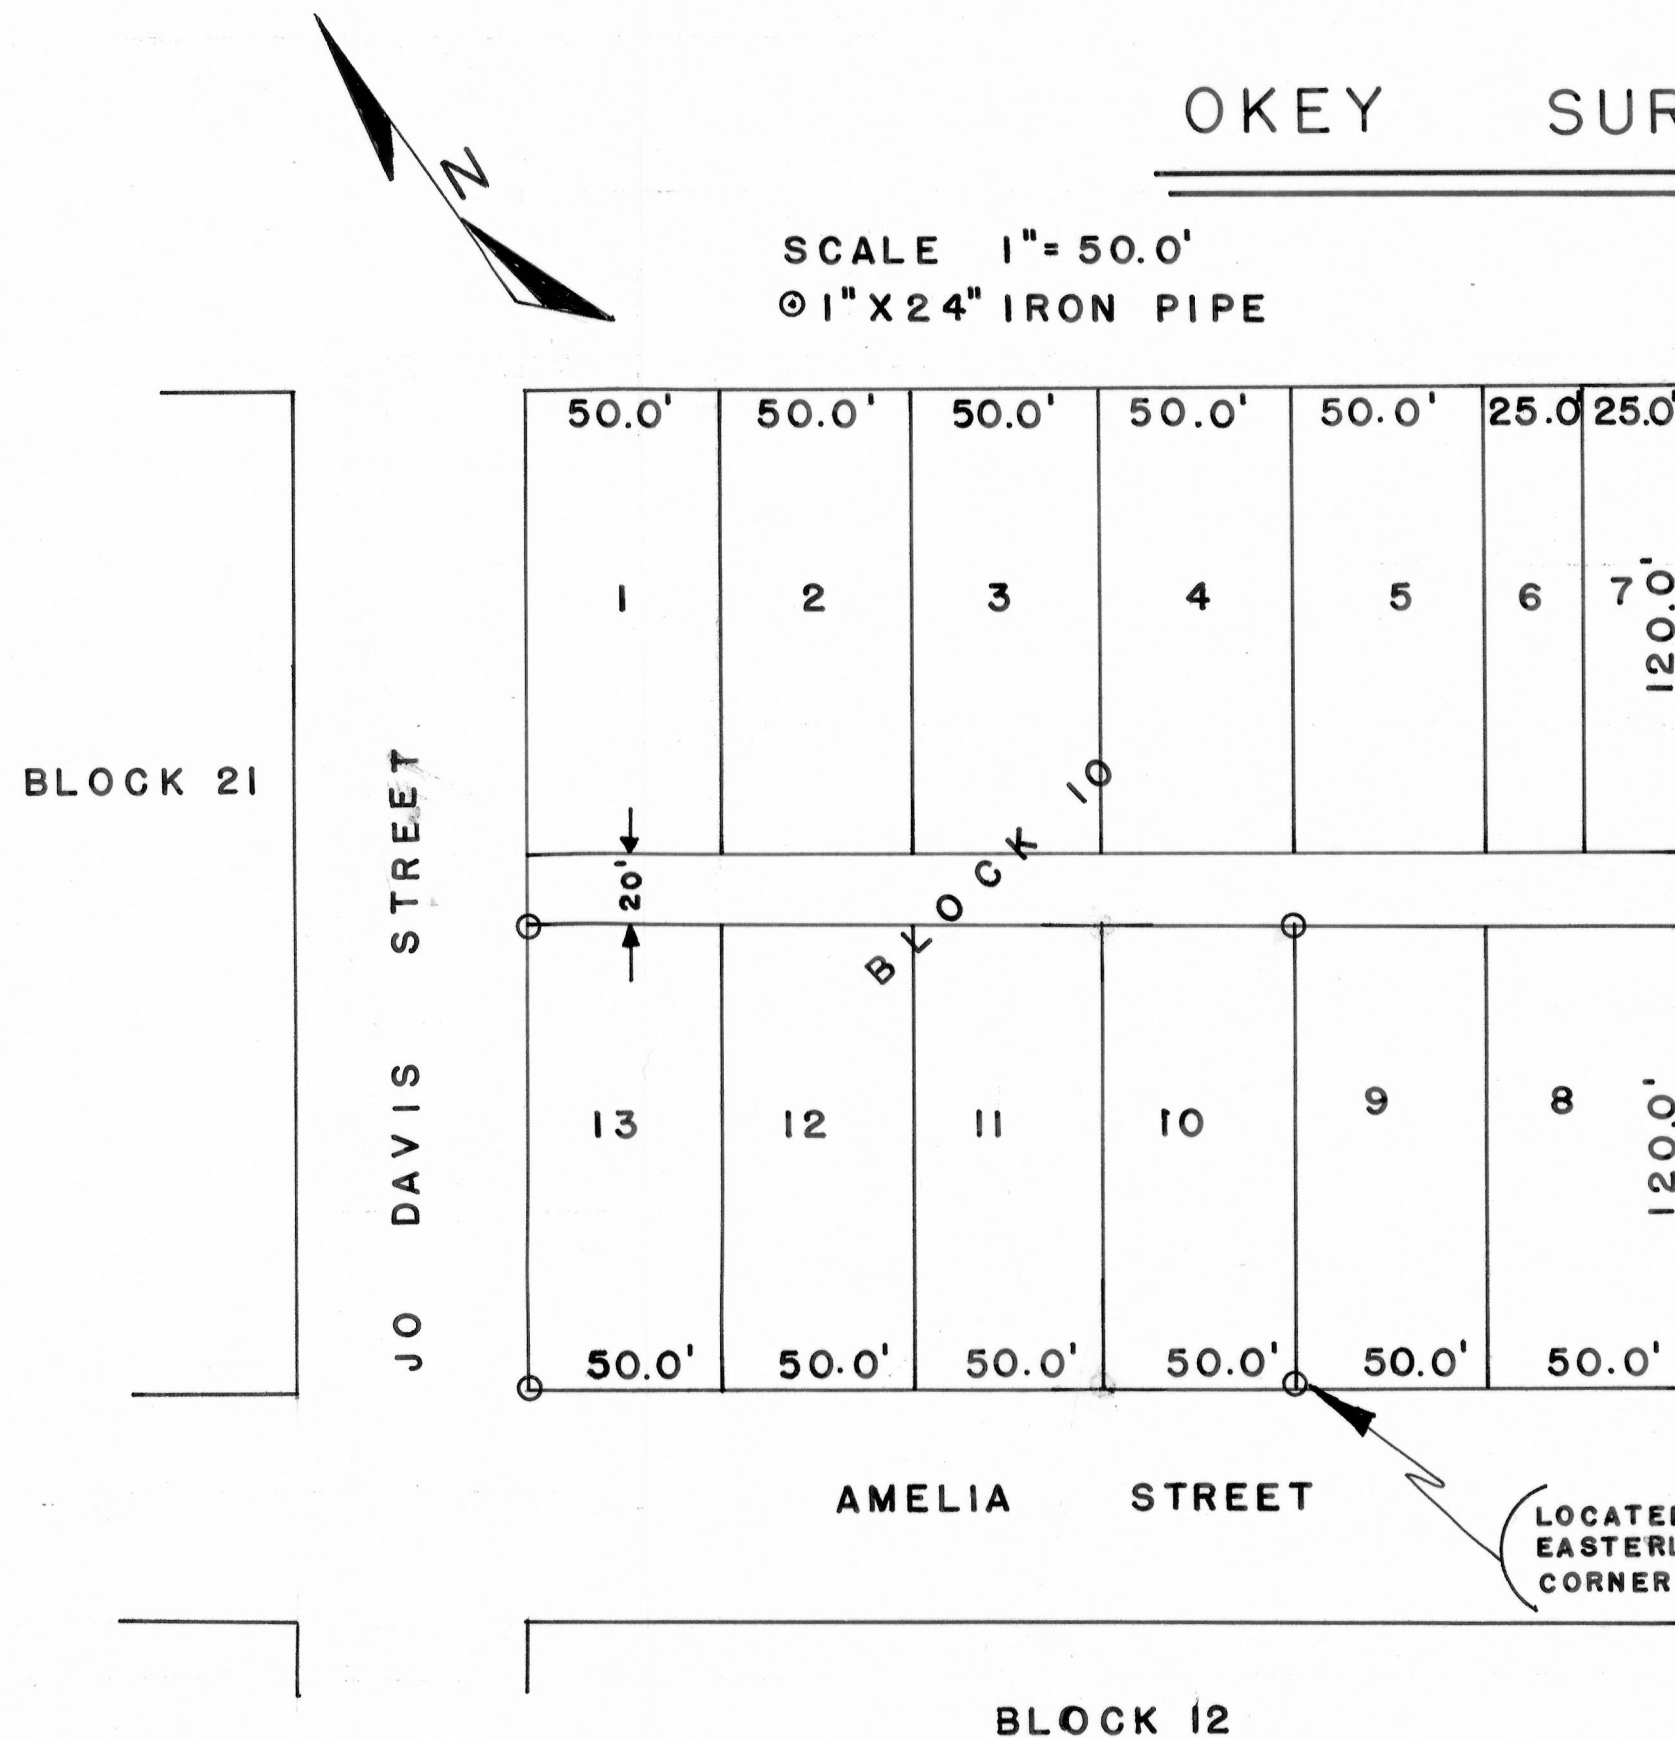

Description

Lot Ten (10), Lot Eleven (11), Lot Twelve (12),
 and Lot Thirteen (13) in Block Ten (10) of the
 original plat of the Village of Cassville,
 Grant County, Wisconsin, according to the
 recorded map and plat thereof.

Art Seymour
 Art Seymour
 7/11/69

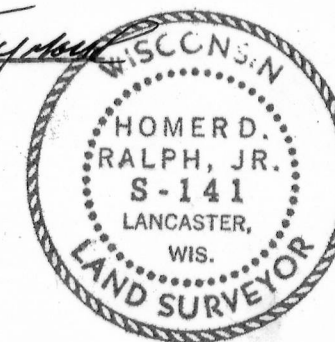

Homer D. Ralph, Jr.
 Homer D. Ralph, Jr.
 Surveyor for Grant
 Co. Wisconsin