


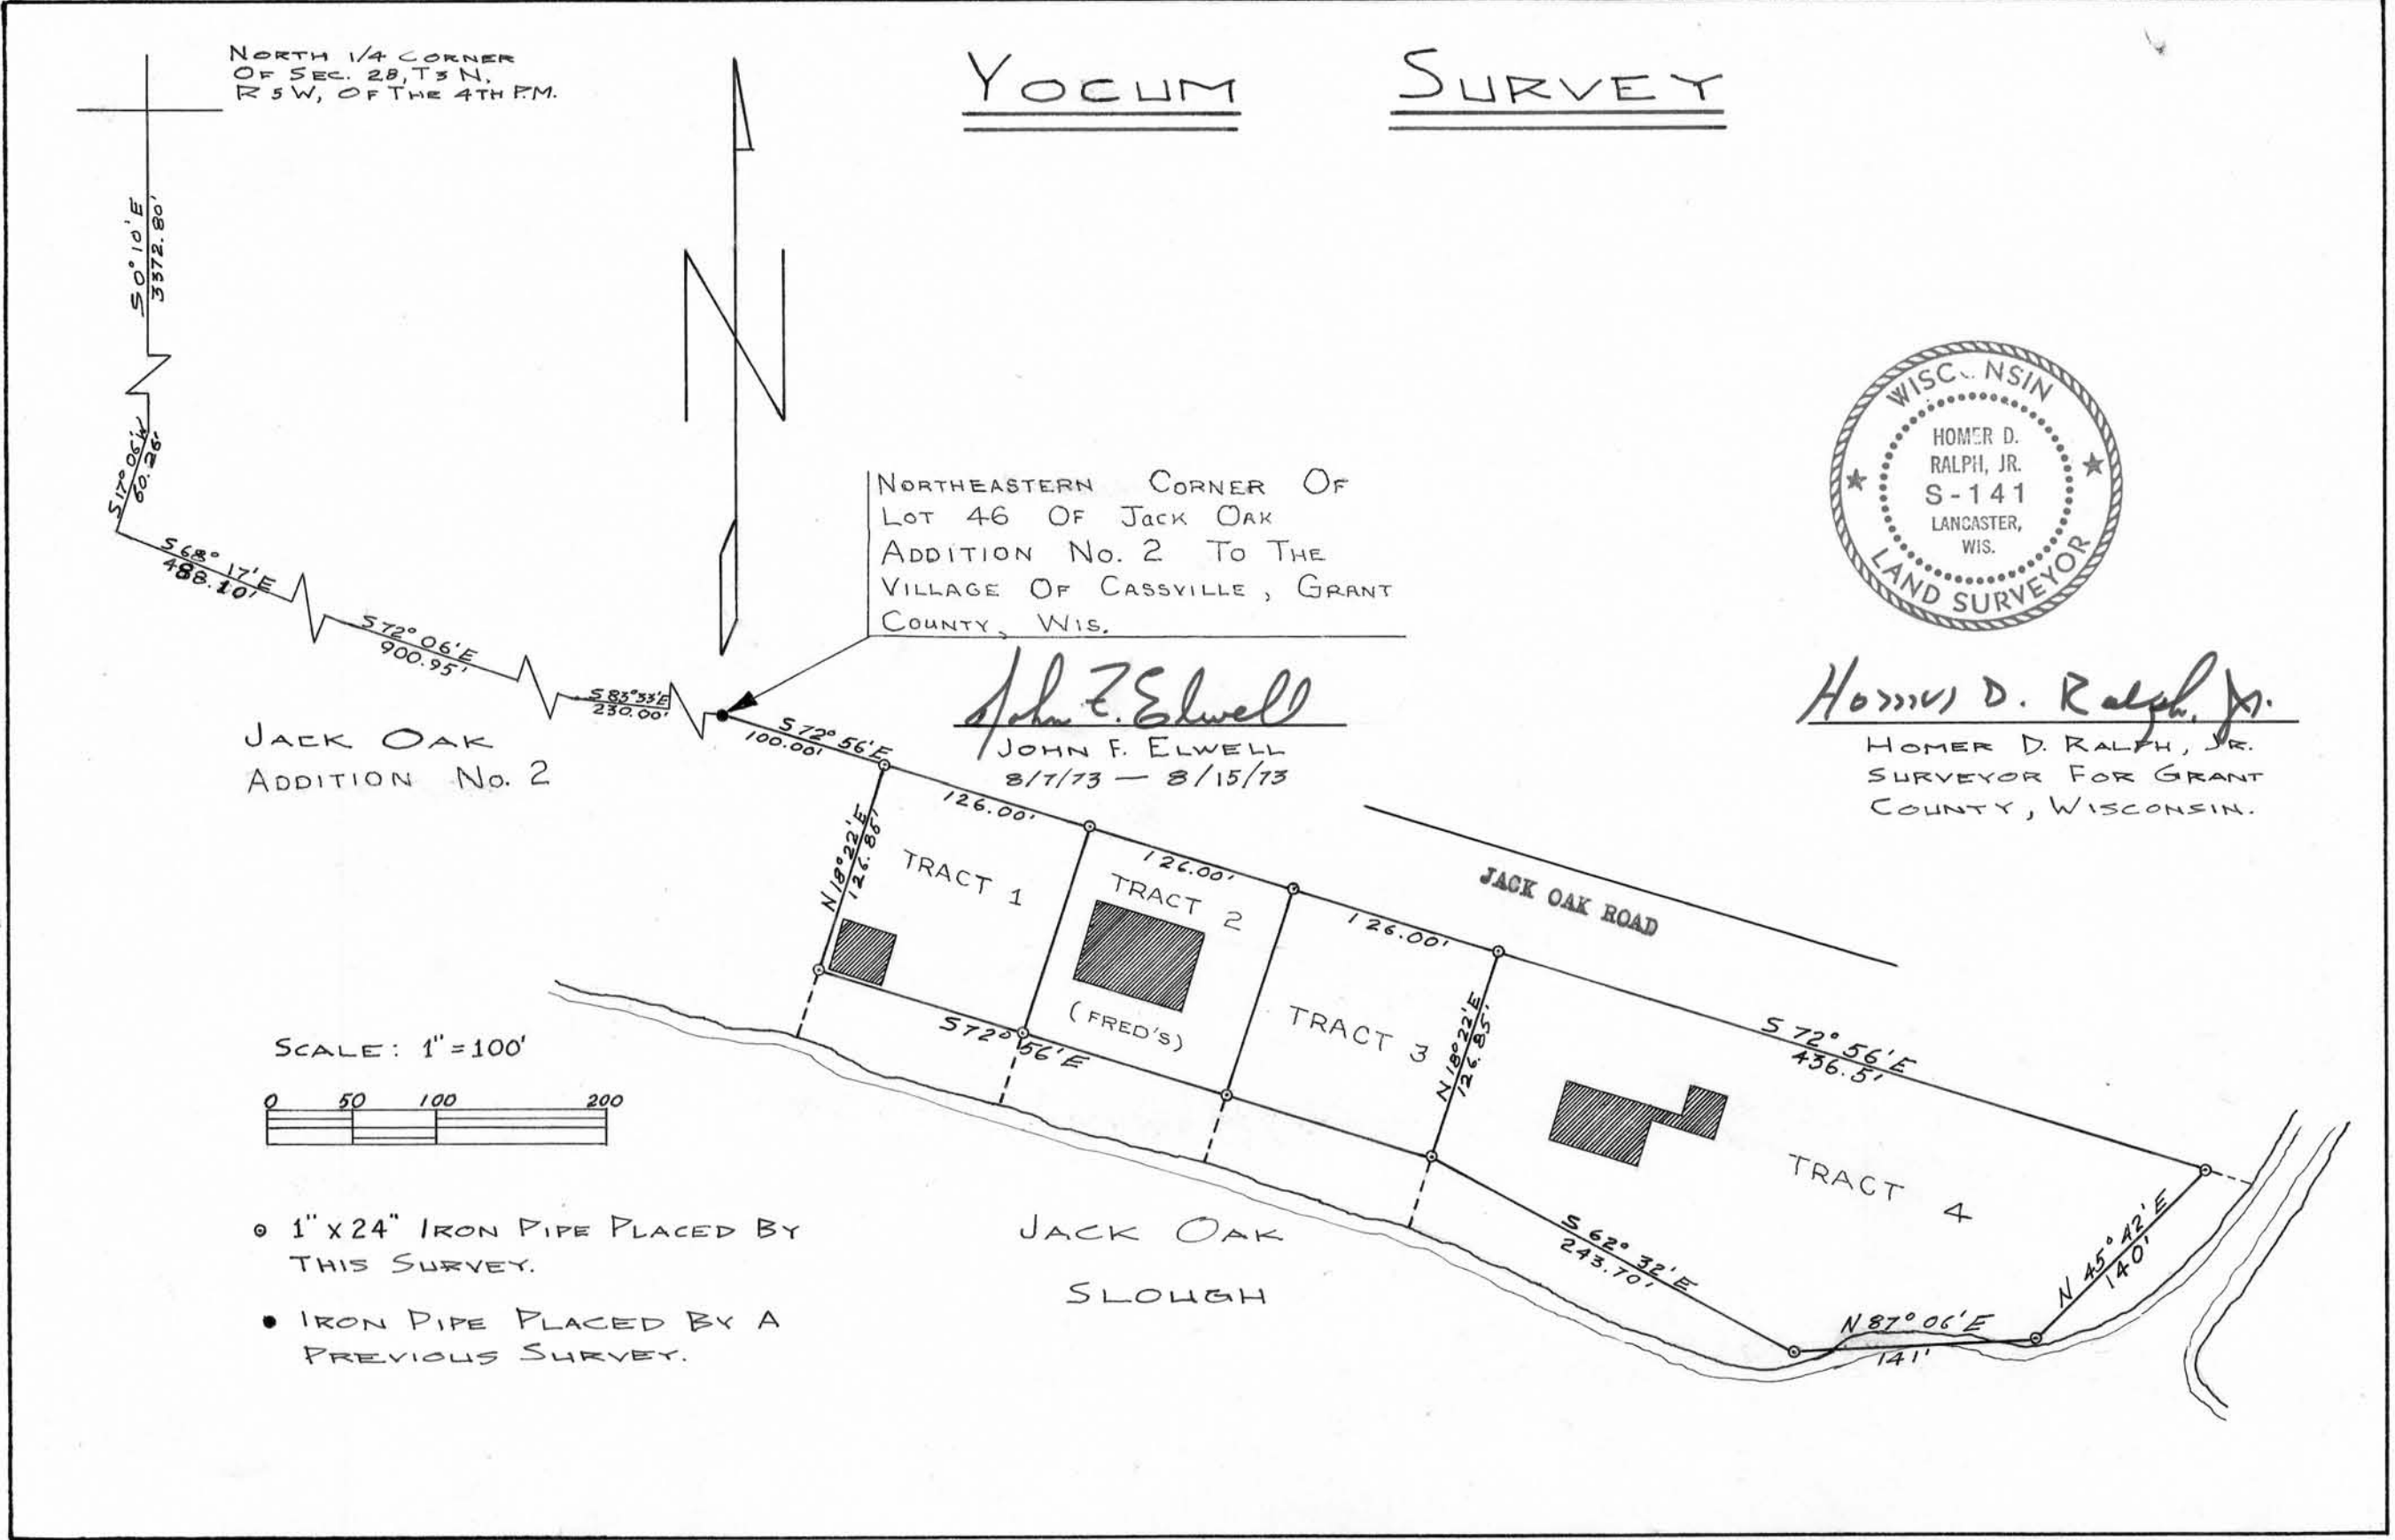

YOCUM SURVEY DESCRIPTIONS

TRACT 1

Part of Government Lot 4, Section 28, T 3 N, R 5 W. of the 4th P.M., in the Village of Cassville, Grant County, Wisconsin, described as follows, to-wit: Begin at a point on the Southerly right-of-way line of Jack Oak Road which is South $72^{\circ} 56'$ East 100.00 feet from the Northeastern corner of Lot 46 of Jack Oak Addition No. 2 to the said Village of Cassville; thence South $72^{\circ} 56'$ East 126.00 feet along said right-of-way line; thence South $18^{\circ} 22'$ West 126.85 feet; thence North $72^{\circ} 56'$ West 126.00 feet; thence North $18^{\circ} 22'$ East 126.85 feet to the point of beginning.

Also all that land lying between the above described land and the ordinary high water mark of Jack Oak Slough.

TRACT 2 (Fred's)

Part of Government Lot 4 of Section 28, T 3 N, R 5 W. of the 4th P.M., in the Village of Cassville, Grant County, Wisconsin, described as follows, to-wit: Begin at a point on the Southerly right-of-way line of Jack Oak Road which is South $72^{\circ} 56'$ East 226.00 feet from the Northeastern corner of Lot 46 of Jack Oak Addition No. 2 to the said Village of Cassville; thence South $72^{\circ} 56'$ East 126.00 feet along said right-of-way line; thence South $18^{\circ} 22'$ West 126.85 feet; thence North $72^{\circ} 56'$ West 126.00 feet; thence North $18^{\circ} 22'$ East 126.85 feet to the point of beginning.

Also all that land lying between the above described land and the ordinary high water mark of Jack Oak Slough.

Page two

YOCUM SURVEY DESCRIPTIONS

TRACT 3

Part of Government Lot 4, Section 28, T 3 N, R 5 W. of the 4th P.M. in the Village of Cassville, Grant County, Wisconsin, described as follows, to-wit: Begin at a point on the Southerly right-of-way line of Jack Oak Road which is South $72^{\circ} 56'$ East 352.00 feet from the Northeastern corner of Lot 46 of Jack Oak Addition No. 2 to the said Village of Cassville; thence South $72^{\circ} 56'$ East 126.00 feet along said right-of-way line; thence South $18^{\circ} 22'$ West 126.85 feet; thence North $72^{\circ} 56'$ West 126.00 feet; thence North $18^{\circ} 22'$ East 126.85 feet to the point of beginning. Also all that land lying between the above described land and the ordinary high water mark of Jack Oak Slough.

TRACT 4

Part of Government Lot 4, Section 28, T 3 N, R 5 W. of the 4th P.M. in the Village of Cassville, Grant County, Wisconsin, described as follows, to-wit: Begin at a point on the Southerly right-of-way line of Jack Oak Road which is South $72^{\circ} 56'$ East 478.00 feet from the Northeastern corner of Lot 46 of Jack Oak Addition No. 2 to the said Village of Cassville; thence South $72^{\circ} 56'$ East 436.50 feet; thence South $45^{\circ} 42'$ West 140.00 feet; thence South $87^{\circ} 06'$ West 141.00 feet; thence North $62^{\circ} 32'$ West 243.70 feet; thence North $18^{\circ} 22'$ East 126.85 feet to the point of beginning. Also all that land lying between the above described land and the ordinary high water mark of Jack Oak Slough.

Page three

YOCUM SURVEY DESCRIPTIONS

DESCRIPTION OF TOTAL AREA (TRACTS 1, 2, 3 and 4)

Part of Government Lot 4, Section 28, T 3 N, R 5 W. of the 4th P.M. in the Village of Cassville, Grant County, Wisconsin described as follows, to-wit: Begin at a point on the Southerly right-of-way line of Jack Oak Road which is South $72^{\circ} 56'$ East 100.00 feet from the Northeastern corner of Lot 46 of Jack Oak Addition No. 2 to said Village of Cassville; thence South $72^{\circ} 56'$ East 914.50 feet; thence South $45^{\circ} 42'$ West 140 feet; thence South $87^{\circ} 06'$ West 141 feet; thence North $62^{\circ} 32'$ West 243.70 feet; thence North $72^{\circ} 56'$ West 378.00 feet; thence North $18^{\circ} 22'$ East 126.85 feet to the point of beginning. Also all that land lying between the above described land and the ordinary high water mark of Jack Oak Slough.



Homer D. Ralph, Jr.
Homer D. Ralph, Jr. R/S