


NORTHUP-KING SURVEY

SCALE: 1" = 60'

- 1" X 24" Iron pipe placed by this Survey.
- P.K. nail placed in pavement.

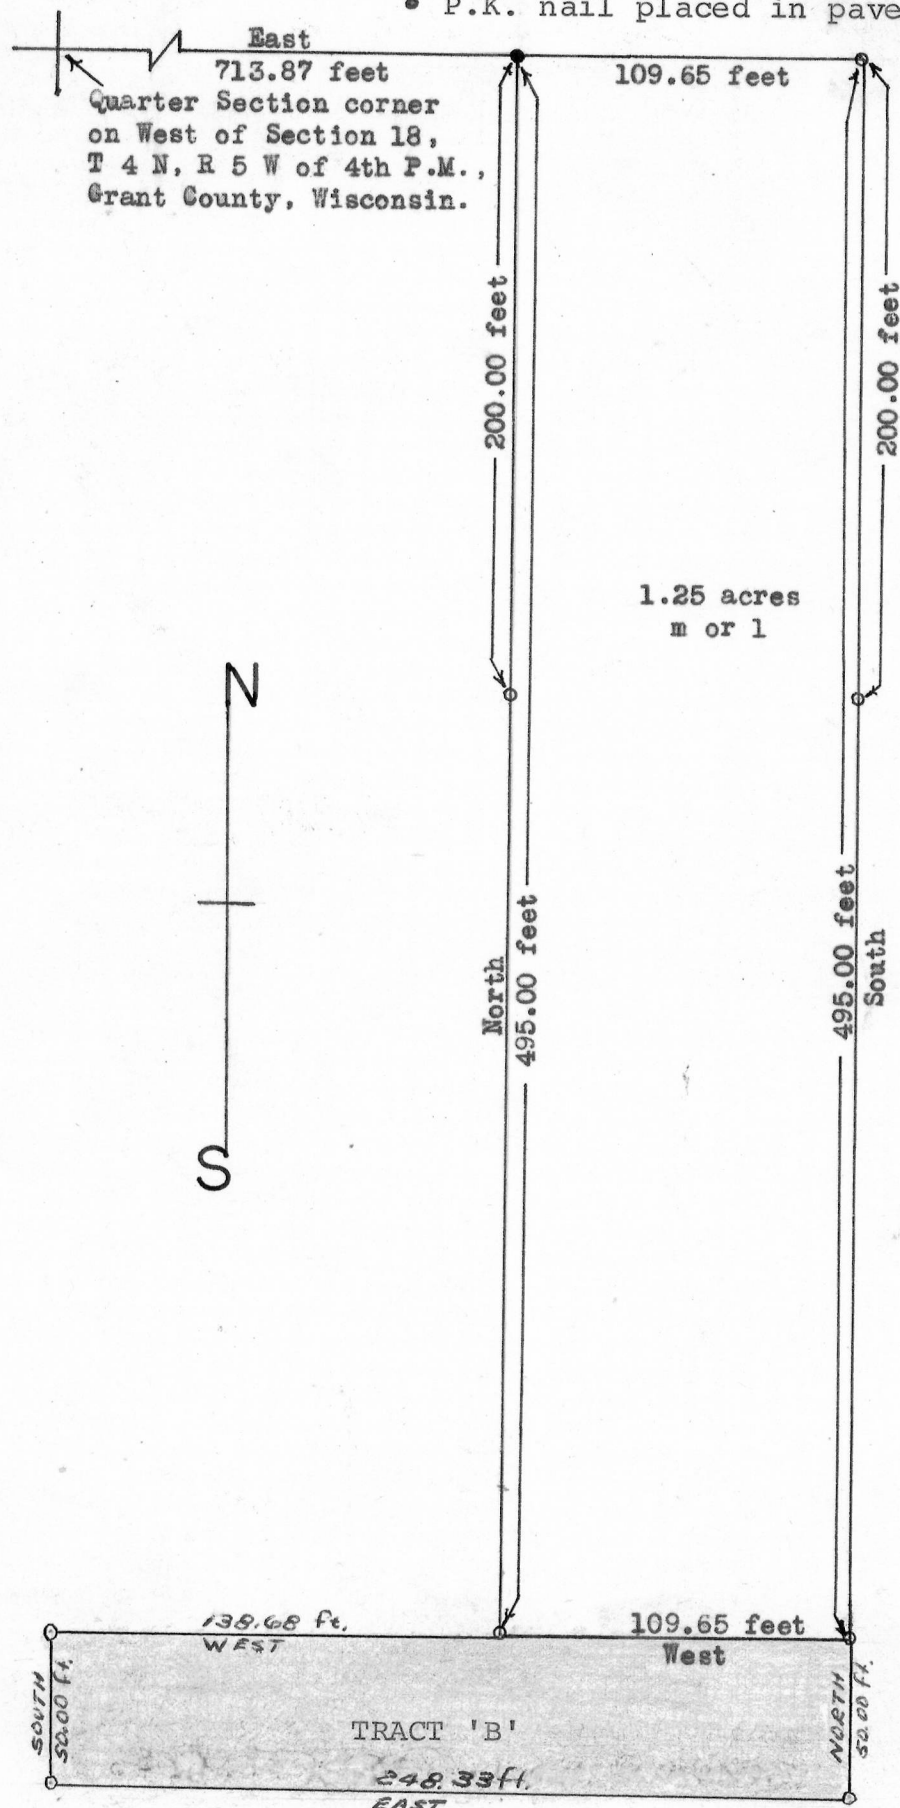

DESCRIPTION:

Begin at a point which is 713.87 feet East of the West Quarter corner of Section 18, T 4 N, R 5 W of the 4th P.M., Grant County, Wisconsin; thence East 109.65 feet; thence South 495.00 feet; thence West 109.65 feet; thence North 495.00 feet to the point of beginning. Containing 1.25 acres more or less.



Homer D. Ralph, Jr.
Homer D. Ralph, Jr.
Surveyor for Grant
County, Wisconsin.

Ralph Bourret
Ralph Bourret
8/18-8/19/72
8/30 - 9/2/72

DESCRIPTION: (Tract 'B')

Begin at a point which is 823.52 feet East and 495.00 feet South of the West Quarter corner of Section 18, T 4 N, R 5 W of the 4th P.M., Grant County, Wisconsin; thence West 248.33 feet; thence South 50.00 feet; thence East 248.33 feet; thence North 50.00 feet to the place of beginning. Containing 0.29 acres more or less.