



# WILLIAM WILLIAMS SURVEY

SCALE: 1" = 100'

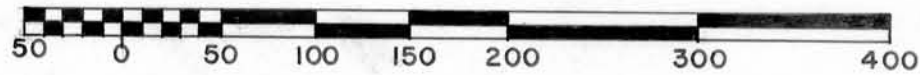

NORTHWEST CORNER  
OF N.E. 1/4, OF N.E. 1/4,  
SECTION 25, T 4 N,  
R 5 W.

N

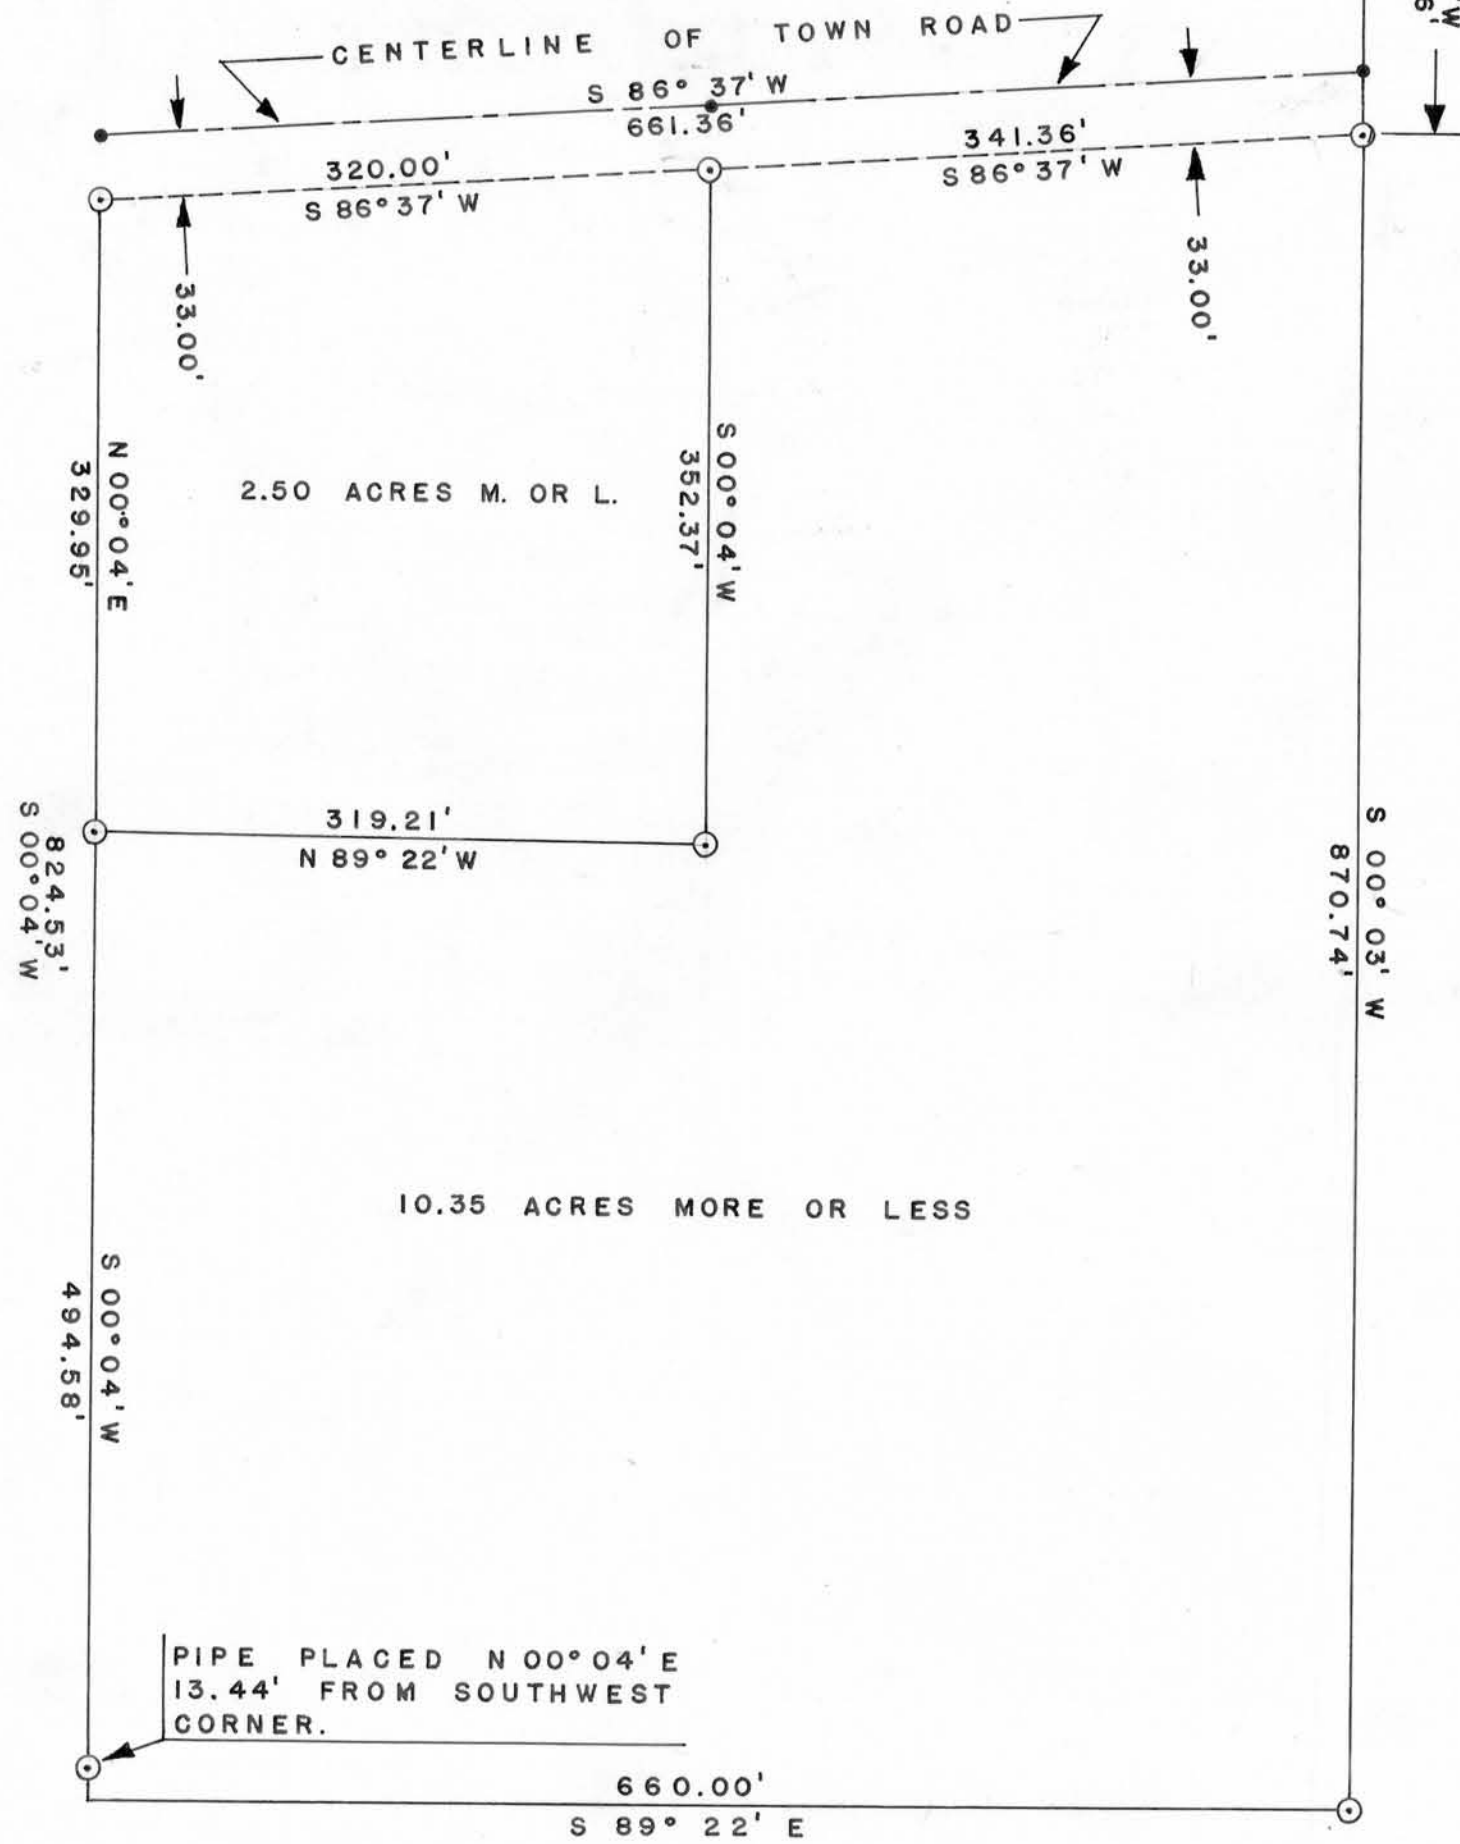

## LEGEND:


⊙ 1" X 24" IRON PIPE PLACED BY THIS SURVEY

• NAIL PLACED BY THIS SURVEY

----- RIGHT-OF-WAY

----- CENTERLINE

*David K. Krohn*  
DAVID K. KROHN  
4/23/74 - 5/9/74

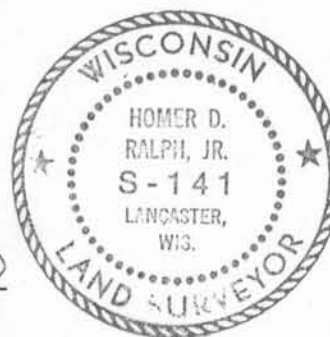

*Homer D. Ralph, Jr.*  
HOMER D. RALPH, JR.  
SURVEYOR FOR GRANT  
COUNTY, WISCONSIN.

WILLIAM WILLIAMS

DESCRIPTION:

Part of the E.1/2 of the S.W.1/4 of the N.E.1/4 of Section 25,  
T 4 N, R 5 W, of the 4th P.M., Grant County, Wisconsin, described  
as follows to-wit:

Begin at the Northwest Corner of the N.E.1/4 of the N.E.1/4 of  
said Section 25;

thence South 00° 03' West 1769.26 feet to a point on the South  
right-of-way of town road and the point of beginning;

thence South 86° 37' West 341.36 feet along said right-of-way;

thence South 00° 04' West 352.37 feet;

thence North 89° 22' West 319.21 feet;

thence South 00° 04' West 494.58 feet;

thence South 89° 22' East 660.00 feet;

thence North 00° 03' East 870.74 feet to a point on the South  
right-of-way of town road and the point of beginning.

Containing 10.35 acres more or less.



*Homer D. Ralph, Jr.*  
Homer D. Ralph, Jr.  
Surveyor for Grant  
County, Wisconsin.

WILLIAM WILLIAMS

DESCRIPTION:

Part of the E.1/2 of the S.W.1/4 of the N.E.1/4 of Section 25,  
T 4 N, R 5 W, of the 4th P.M., Grant County, Wisconsin, described  
as follows to-wit;

Begin at the Northwest Corner of the N.E.1/4 of the N.E.1/4 of  
said Section 25;

thence South 00° 03' West 1769.26 feet to a point on the South  
right-of-way of town road;

thence South 86° 37' West 341.36 feet along said right-of-way  
to the point of beginning;

thence South 86° 37' West 320.00 feet along said right-of-way;

thence South 00° 04' West 329.95 feet;

thence South 89° 22' East 319.21 feet;

thence North 00° 04' East 352.37 feet to a point on the South  
right-of-way of town road and the point of beginning.

Containing 2.50 acres more or less.



*Homer D. Ralph, Jr.*  
Homer D. Ralph, Jr.  
Surveyor for Grant  
County, Wisconsin.