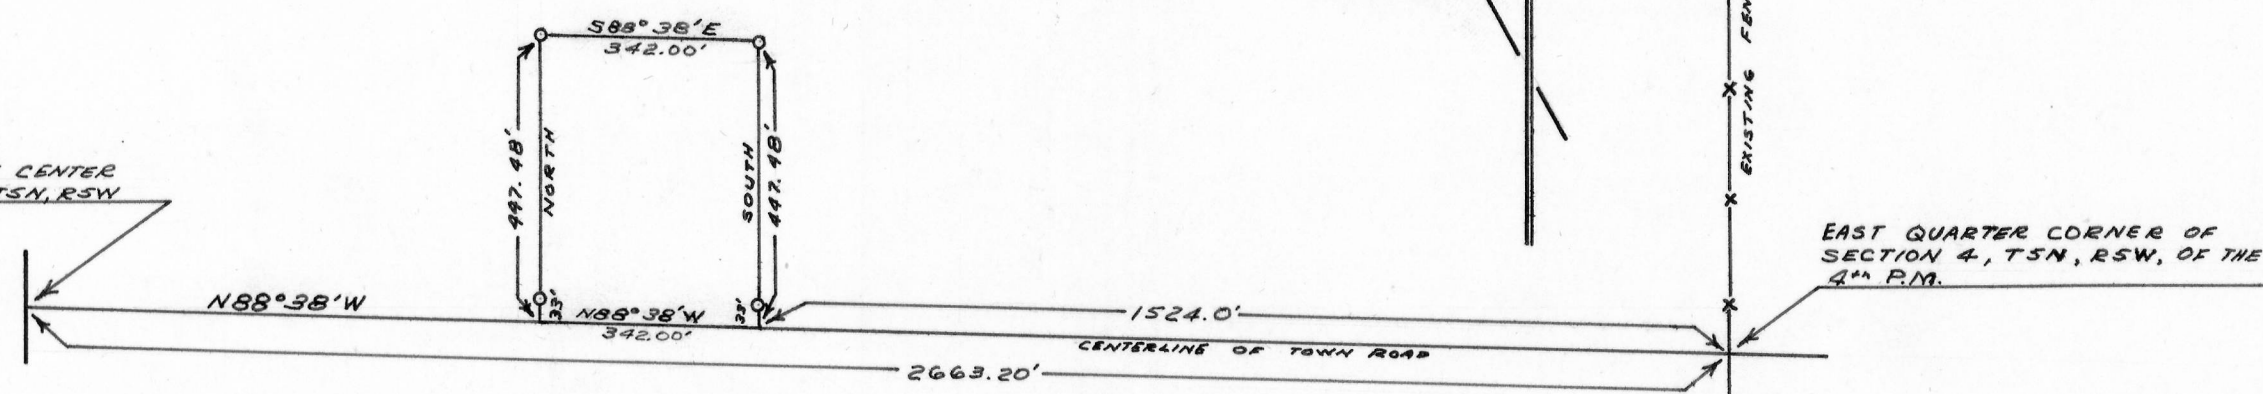


1" = 300'

GORDON GRIFFIN SURVEY

SCALE: 1" = 300'

o 1" X 24" Iron pipe placed by this survey.

STONE FOUND AT CENTER
OF SECTION 4, T5N, R5WPrevious Description:

A part of the S.W.1/4 of the N.E.1/4 of Section 4, T 5 N, R 5 W. of the 4th P.M., Grant County, Wisconsin, described as follows to-wit:

Begin at a point which is 1506 feet West of the East Quarter corner of said Section 4; thence West 342.00 feet; thence North 447.48 feet; Thence East 342.00 feet; thence South 447.48 feet to the Place of beginning.


Survey Description:

A part of the S.W.1/4 of the N.E.1/4 of Section 4, T 5 N, R 5 W. of the 4th P.M., Grant County, Wisconsin, described as follows, to-wit:

Begin at a point which is North 88° 38' West 1524.00 feet from the East Quarter corner of said Section 4; thence North 88° 38' West 342.00 feet along the centerline of the town road; thence North 447.48 feet;

Charles Lange
 Charles Lange
 6/14 - 6/23/72

Homer D. Ralph, Jr.
 Homer D. Ralph, Jr.
 Surveyor for Grant
 County, Wisconsin.

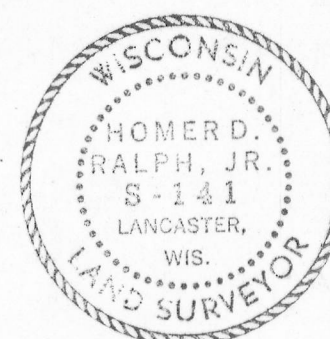survey description (continued)

thence South 88° 38' East 342.00 feet; thence South 447.48 feet to the place of beginning.