



HAMPTON SURVEY

SCALE 1" = 100'

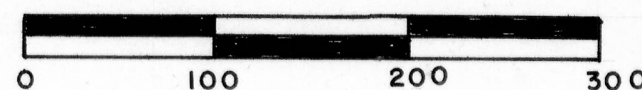

⊙ DENOTES 1"X24" IRON PIPE

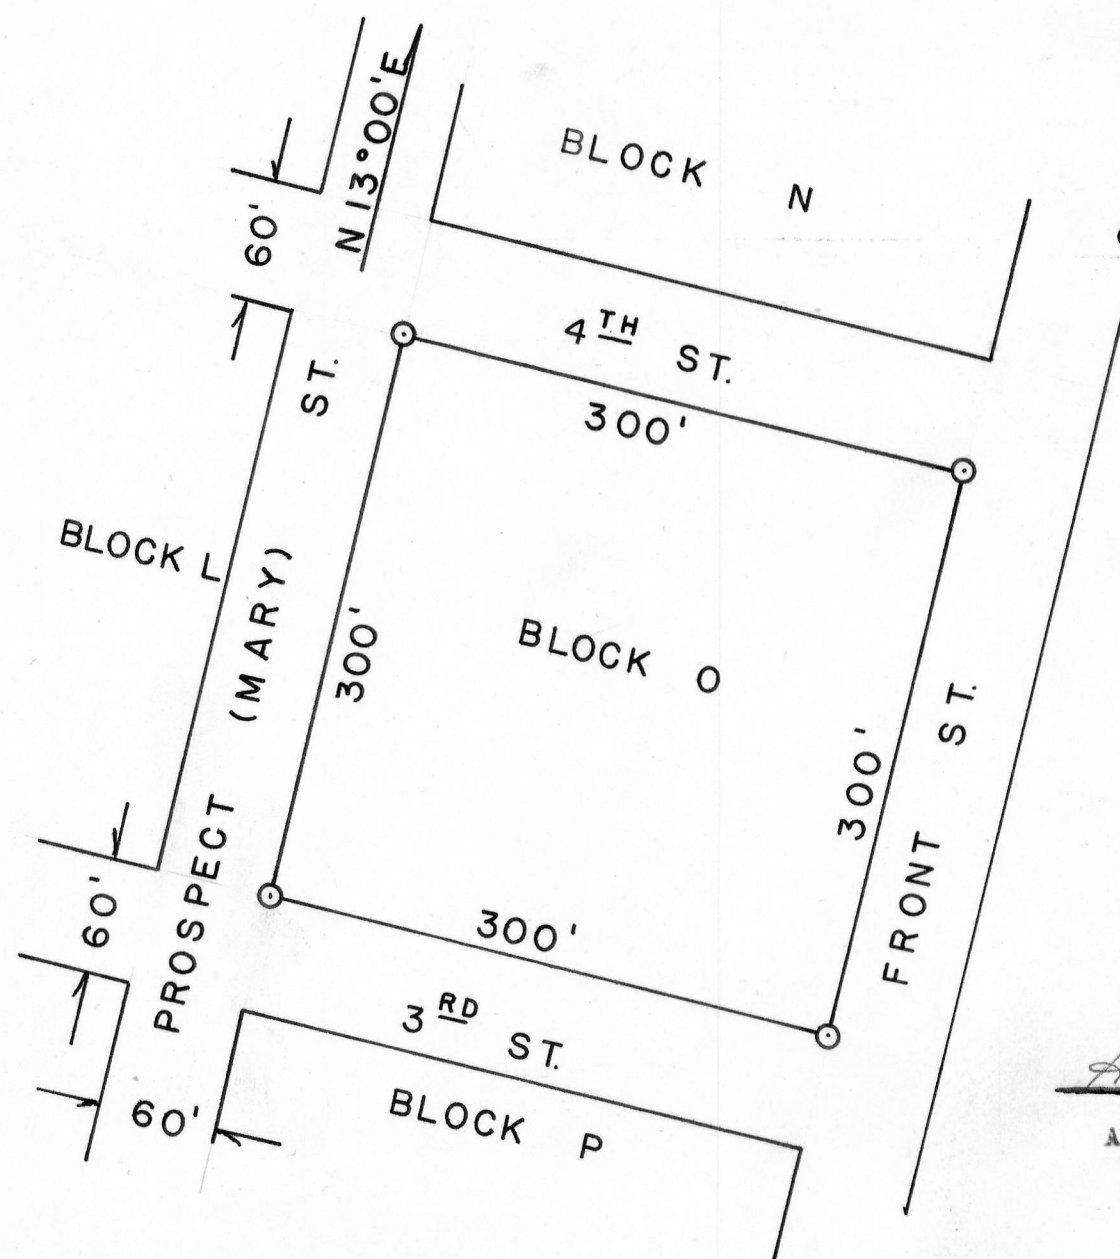

Description:

Block "O" of Taft's Addition to the Village of Bloomington,
Grant County, Wisconsin. According to the recorded map or
plat there of.



Art Seymour

Art Seymour 9/2/69- 9/3/69

Homer D. Ralph, Jr.

Homer D. Ralph Jr.

Surveyor for Grant County, Wis.