


OSCAR MAYER SURVEY

SCALE: 1" = 100'

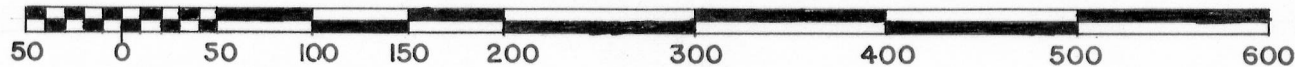

CENTER OF SECTION 27,
T 5 N, R 5 W.

LEGEND:


⊙ 1" X 24" IRON PIPE PLACED BY THIS SURVEY

● P.K. NAIL PLACED BY THIS SURVEY

— CENTERLINE

— RIGHT - OF - WAY

--- CHORD

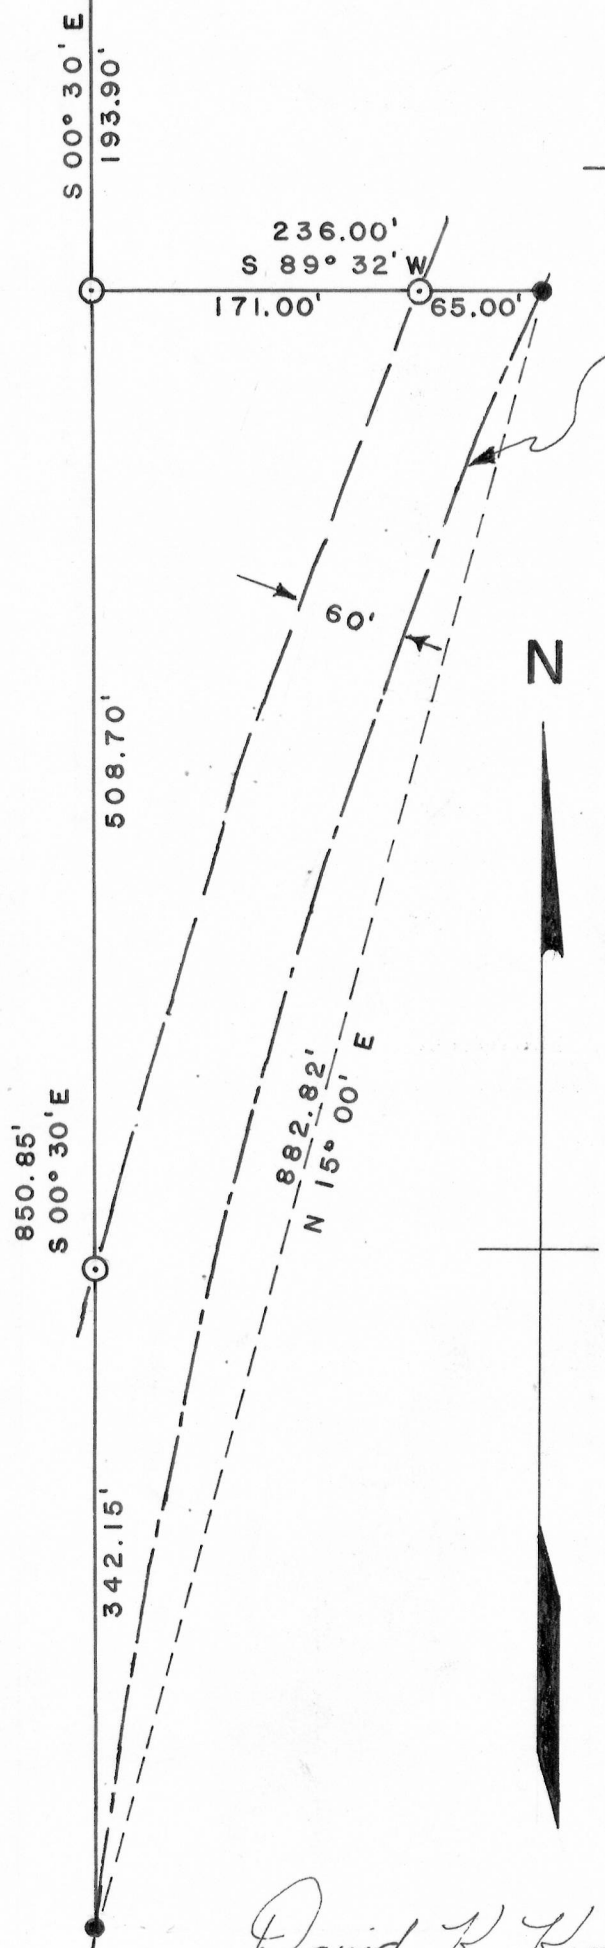

CENTERLINE STATE TRUNK HIGHWAY NO. 133

CURVE DATA

CHORD LENGTH = 882.82'

CHORD BEARING = N 15° 00' E

ARC LENGTH = 886.34'

RADIUS = 2865.00'

AREA

2.19 ACRES INCLUSIVE OF RIGHT-OF-WAY

0.97 ACRES EXCLUSIVE OF RIGHT-OF-WAY

DESCRIPTION

Part of the S.E.1/4 of Section 27, T 5 N, R 5 W, of the 4th P.M., Grant County, Wisconsin, described as follows to-wit:

Begin at the Center of said Section 27; thence South 00° 30' East 193.90 feet to the point of beginning; thence South 00° 30' East 850.85 feet to the centerline of State Trunk Highway #133; thence Northeasterly along said centerline of the arc of a curve concave to the Southeast, whose radius is 2865.00 feet, and whose chord bears North 15° 00' East 882.82 feet; thence South 89° 32' West 236.00 feet to the point of beginning. Containing 2.19 acres more or less inclusive of highway right-of-way.



David K. Krohn
DAVID K. KROHN
5/31/74 - 6/5/74

Homer D. Ralph, Jr.
HOMER D. RALPH, JR.
SURVEYOR FOR GRANT
COUNTY, WISCONSIN.