

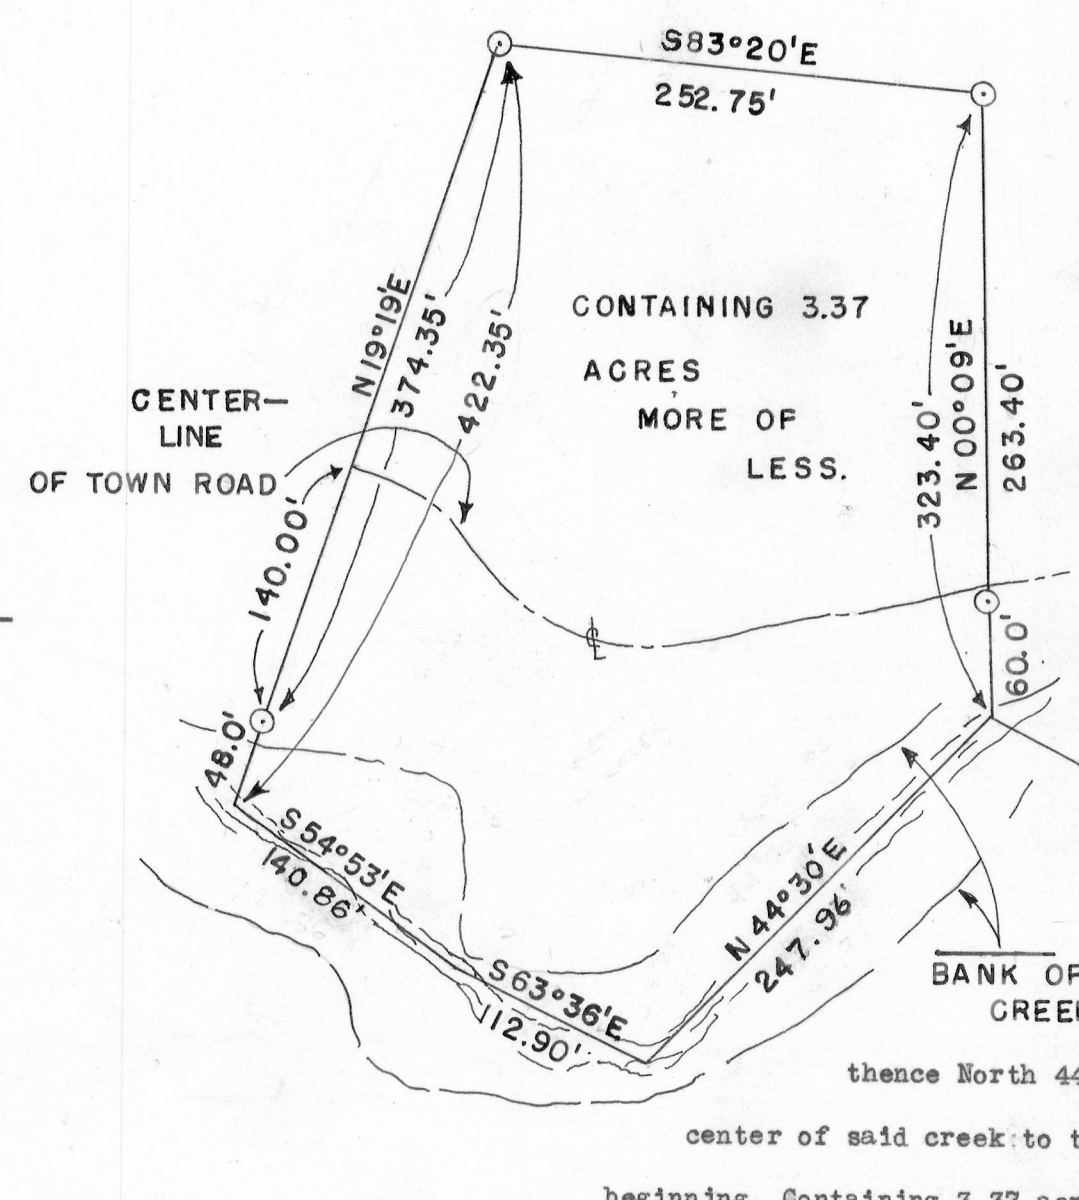


JOHNSTON—DILLEY—FISCHER SURVEY

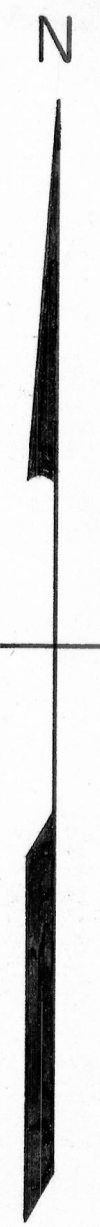

SCALE: 1"=100'

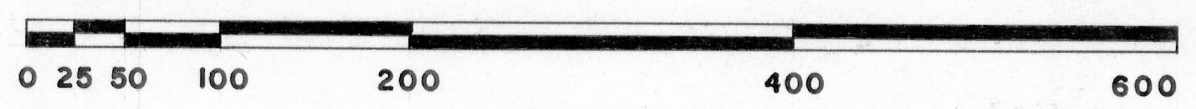

DESCRIPTION


Part of the N.W. 1/4 of N.W. 1/4 of Section 24, T 6 N, R 5 W, of the 4th P.M., Grant County, Wisconsin, described as follows to-wit:

Begin at a point in the center of Mill Creek which is North 62° 19' West 477.15 feet from the Southeast corner of said N.W.1/4 of N.W.1/4;

thence North 00°09' East 323.40 feet;
thence North 83°20' West 252.75 feet;
thence South 19°19' West 422.35 feet to the center of Mill Creek;

thence South 54°53' East 140.86 feet along the centerline of said creek;
thence South 63°36' East 112.90 feet along the center of said creek;

thence North 44°30' East 247.96 feet along the center of said creek to the point of beginning. Containing 3.37 acres more or less inclusive of highway right-of-way.

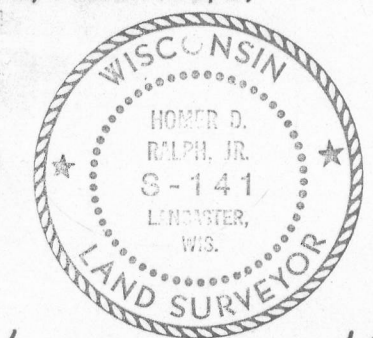

Homer D. Ralph, Jr.
HOMER D RALPH JR
SURVEYOR FOR GRANT
COUNTY, WISCONSIN

David K. Krohn
DAVID K. KROHN
12/21/74 — 12/23/74

LEGEND:

- 1"X 24" IRON PIPE PLACED BY THIS SURVEY
- *** FENCE
- CORNER POST