


CHARLES FINN SURVEY

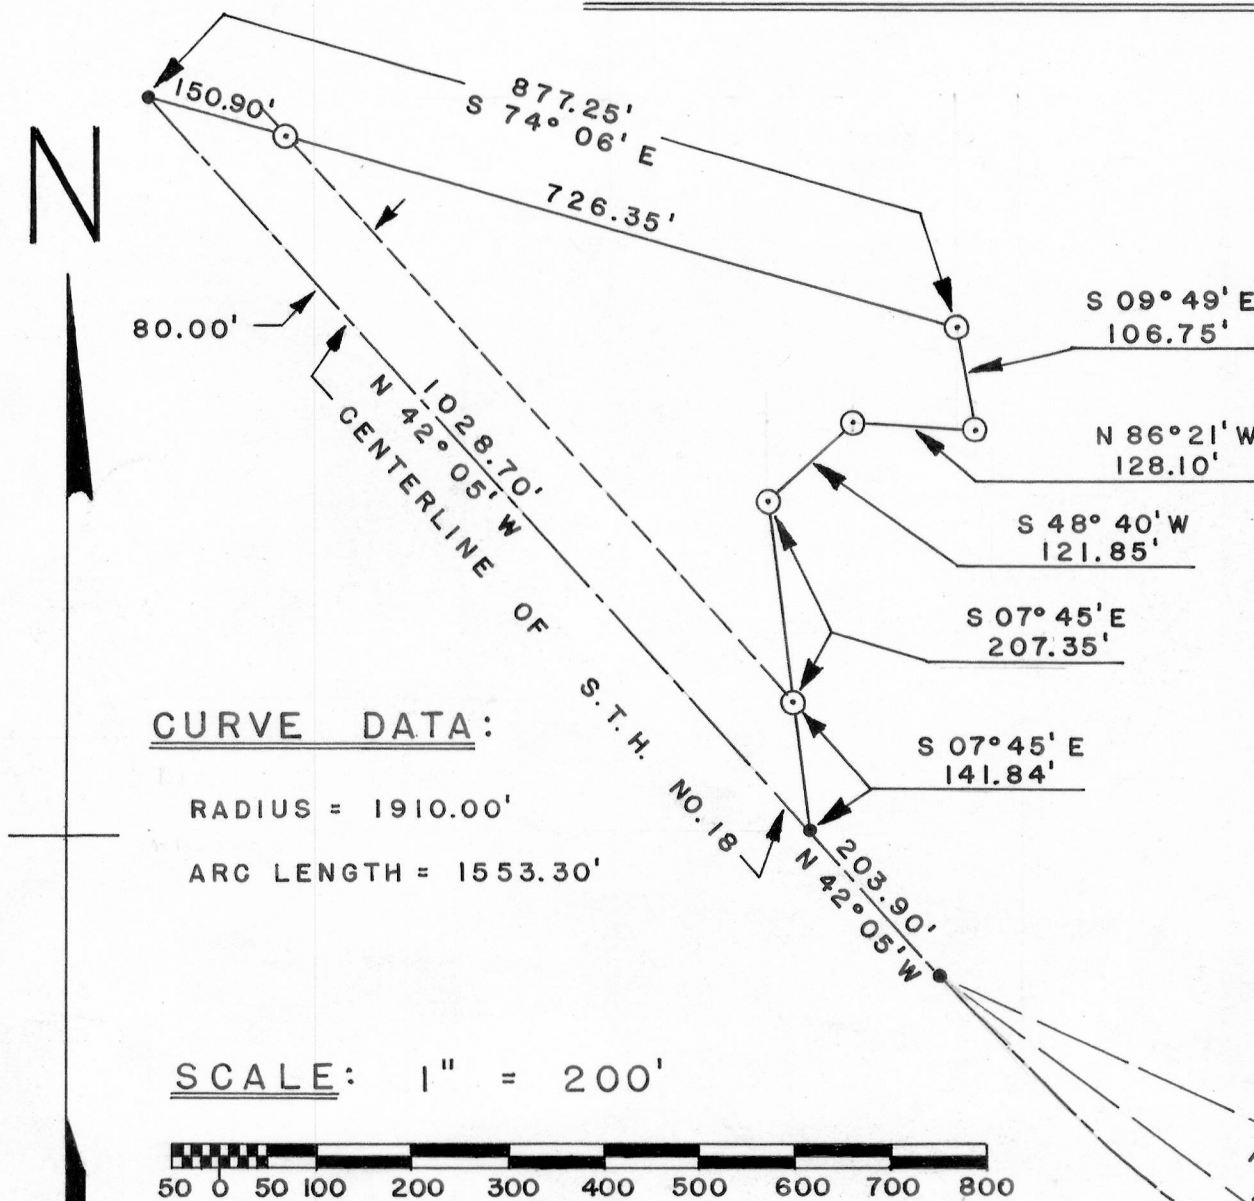

DESCRIPTION:

Part of the N.W.1/4 of Section 33, T 6 N, R 5 W, of the 4th P.M., Grant County, Wisconsin described as follows to-wit: Begin at the center of said Section 33, said point being on the centerline of U.S. Highway #18; thence North 88° 41' West 91.60 feet along said centerline to the P.C. of a curve, concave to the North, having a radius of 1910.00 feet; thence Northwesterly along the arc of said curve 1553.30 feet to the P.T. of said curve having a long chord bearing North 65° 23' West 1510.99 feet; thence North 42° 05' West 203.90 feet to the point of beginning;

thence North 42° 05' West 1028.70 feet along said centerline;

thence South 74° 06' East 877.25 feet;

thence South 09° 49' East 106.75 feet;

thence North 86° 21' West 128.10 feet;


thence South 48° 40' West 121.85 feet;

thence South 07° 45' East 349.19 feet to the centerline of U.S. Highway #18 and the point of beginning. Containing 4.76 acres more or less inclusive of highway right-of-way.

LEGEND:

- ⊙ 1" X 24" IRON PIPE PLACED BY THIS SURVEY
- P.K. NAIL PLACED BY THIS SURVEY
- P.K. NAIL PLACED BY PREVIOUS SURVEY

David K. Krohn
DAVID K. KROHN
3/25/74 - 4/2/74

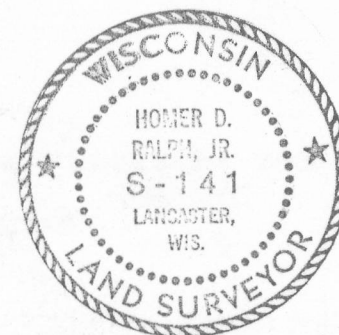

Homer D. Ralph, Jr.
HOMER D. RALPH, JR.
SURVEYOR FOR GRANT
COUNTY, WISCONSIN.

