


BLUM - BURNS SURVEY

SCALE 1"=100'

⊙ 1"X 24" IRON PIPE

--- DENOTE EXISTING FENCE LINE

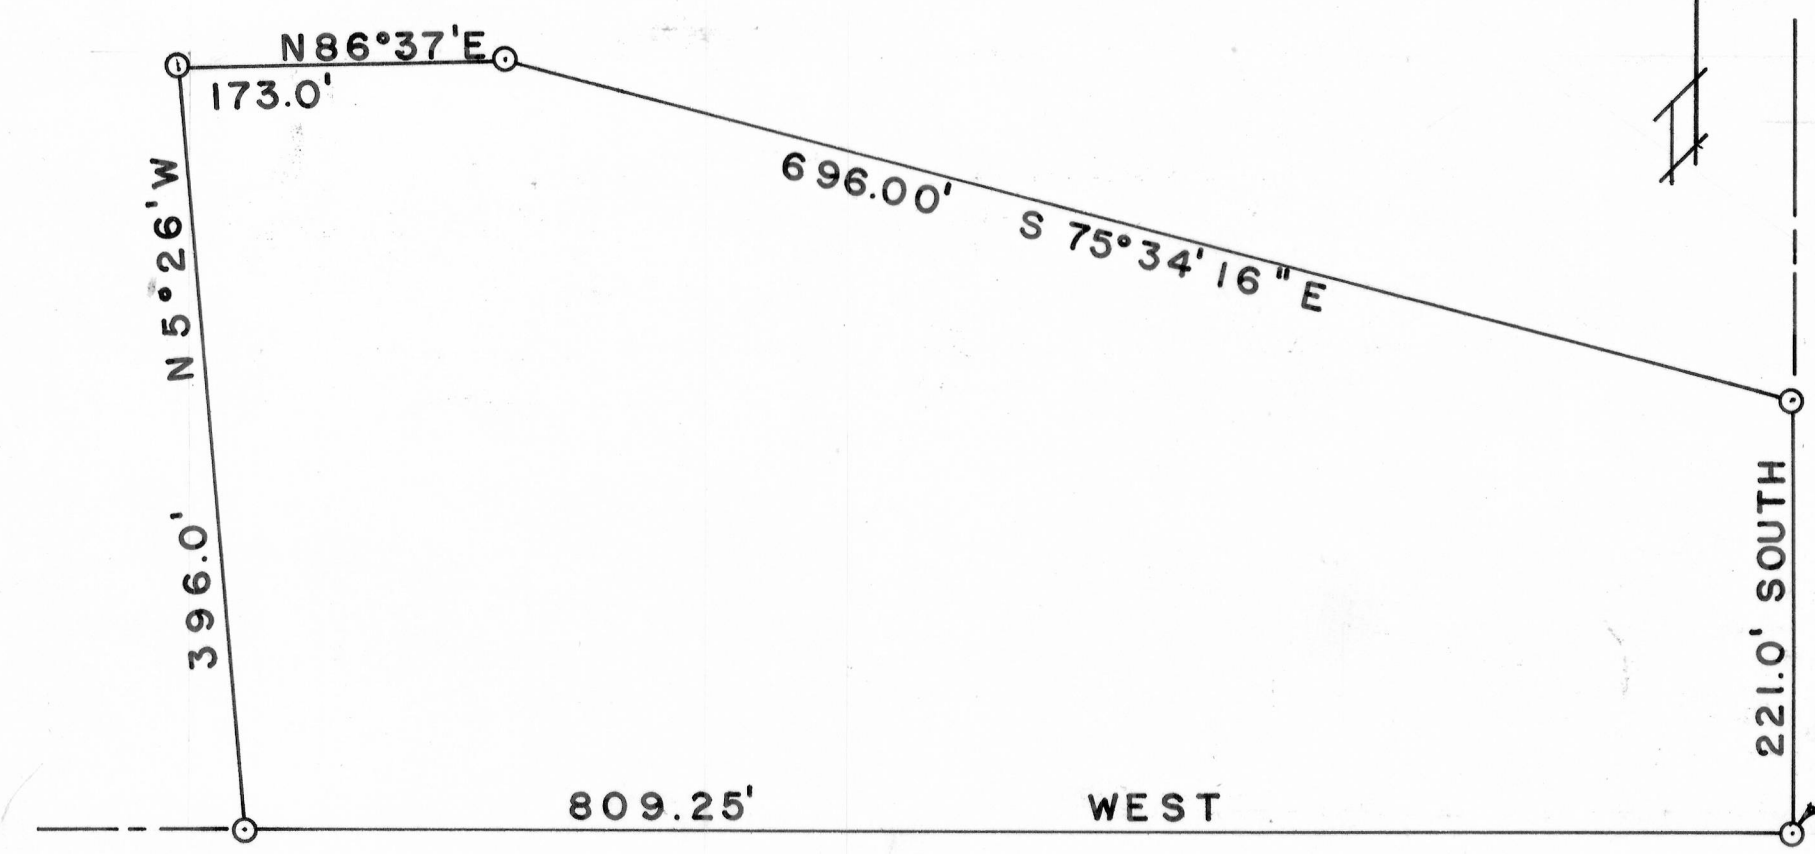

DESCRIPTION

Beginning at the Southeast corner of the S.W.1/4 of the N.W.1/4 of Section 11, T 4 N, R 6 W. of the 4th P.M., Grant County Wisconsin; thence West 809.25 feet; thence North 5° 26' West 396.00 feet; thence North 86° 37' East 173.00 feet; thence South 75° 34' 16" East 696.00 feet; thence South 221.00 feet to the point of beginning.

Art Seymour
Art Seymour
8-11-69



Homer D. Ralph, Jr.
Homer D. Ralph, Jr.
Surveyor for Grant
County, Wisconsin

SOUTHEAST CORNER
OF SOUTHWEST 1/4
OF NORTHWEST 1/4
OF SEC. 11