



# KIRSCHBAUM - BARTON SURVEY

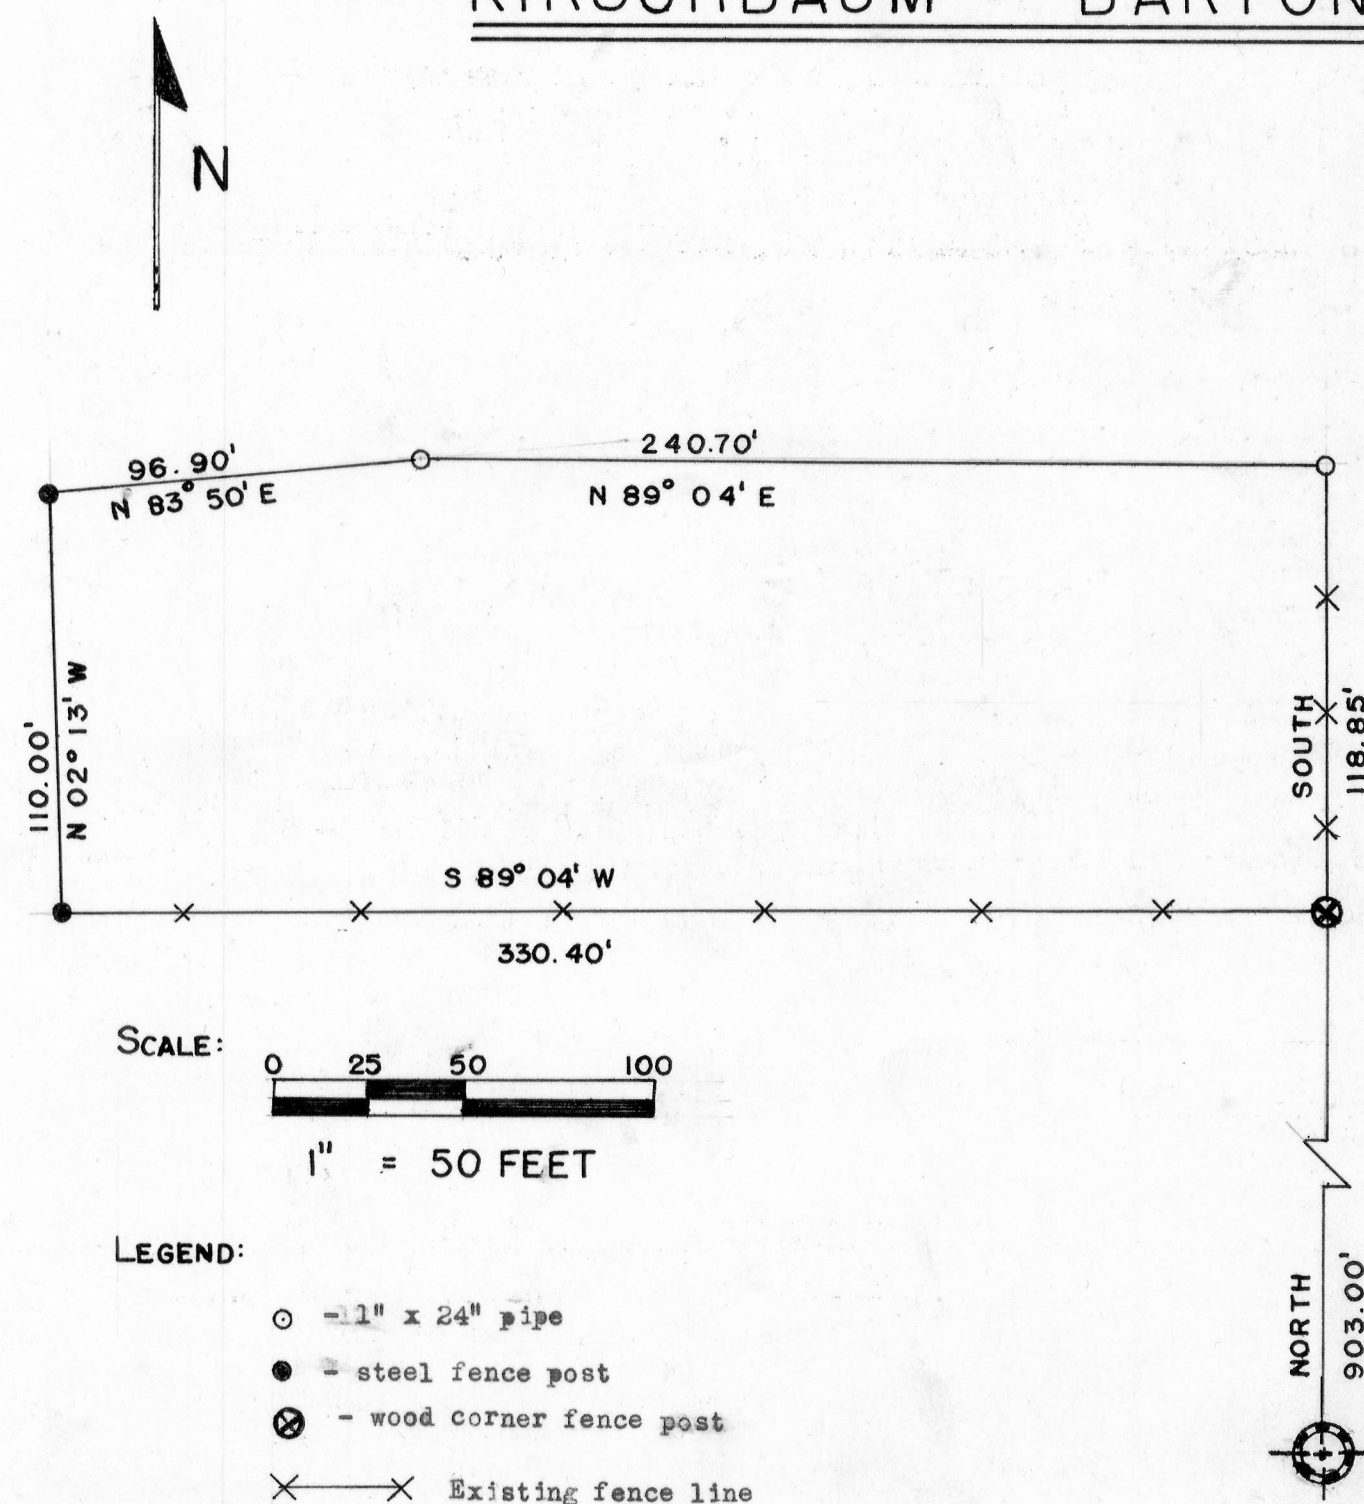

## DESCRIPTION:

A part of the N.E. 1/4 of the N.W. 1/4 of Section 22, T 4 N, R 6 W, of the 4 th. P.M., Grant County, Wisconsin described as follows, to-wit;

Begin at a point which is 903.00 feet North of the Southeast corner of said N.E. 1/4 of the N.W. 1/4; thence South 89° 04' West 330.40 feet; thence North 02° 13' West 110.00 feet; thence North 83° 50' East 96.90 feet; thence North 89° 04' East 240.70 feet; thence South 118.85 feet to the point of beginning. The said parcel of land contains 0.90 acres, more or less.

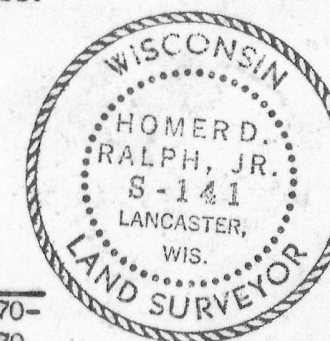

STEVE ABING  
Steve Abing 8/25/70-  
8/26/70

Homer D. Ralph, Jr.  
Homer D. Ralph, Jr.  
Surveyor for Grant  
County, Wisconsin

Southeast corner of  
N.E. 1/4 of the N.W. 1/4  
22-4-6