


6-13 - 7-3-73

# NUTI - BRADLEY SURVEY

SCALE 1" = 30'

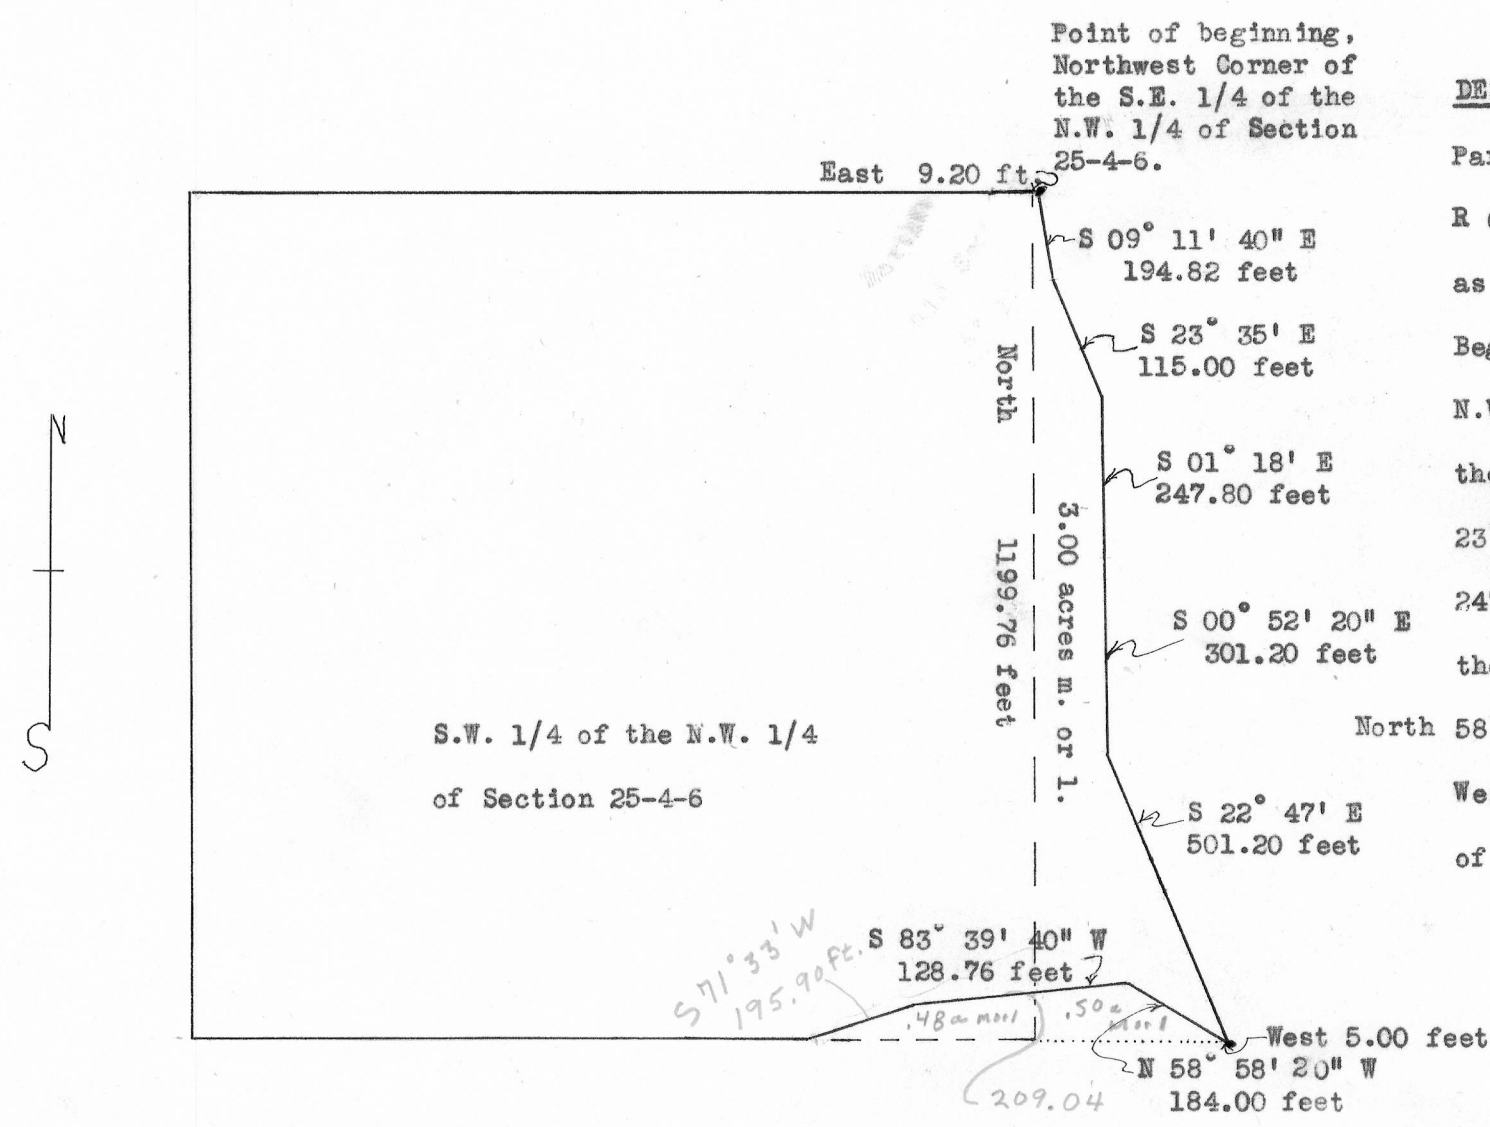


## DESCRIPTION:

Part of the S.E. 1/4 of the N.W. 1/4 of Section 25, T 4 N, R 6 W, of the 4th P.M., Grant County, Wisconsin, described as follows to-wit:

Begin at the Northwest Corner of the S.E. 1/4 of the N.W. 1/4 of said Section 25; thence East 9.20 feet; thence South 09° 11' 40" East 194.82 feet; thence South 23° 35' East 115.00 feet; thence South 01° 18' East 247.80 feet; thence South 00° 52' 20" East 301.20 feet; thence South 22° 47' East 501.20 feet; thence West 5.00 feet; thence North 58° 58' 20" West 184.00 feet; thence South 83° 39' 40" West 128.76 feet; thence North 1199.76 feet to the point of beginning. Containing 3.00 acres more or less.

• - 1" X 24" Iron pipe placed by this survey.

Ralph Bourret  
Ralph Bourret  
6/13-7/3/73

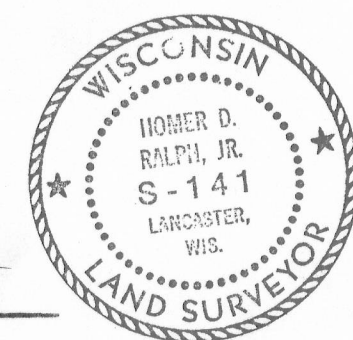

Homer D. Ralph, Jr.  
Homer D. Ralph, Jr.  
Surveyor for Grant  
County, Wisconsin.

206.50

794-2576