


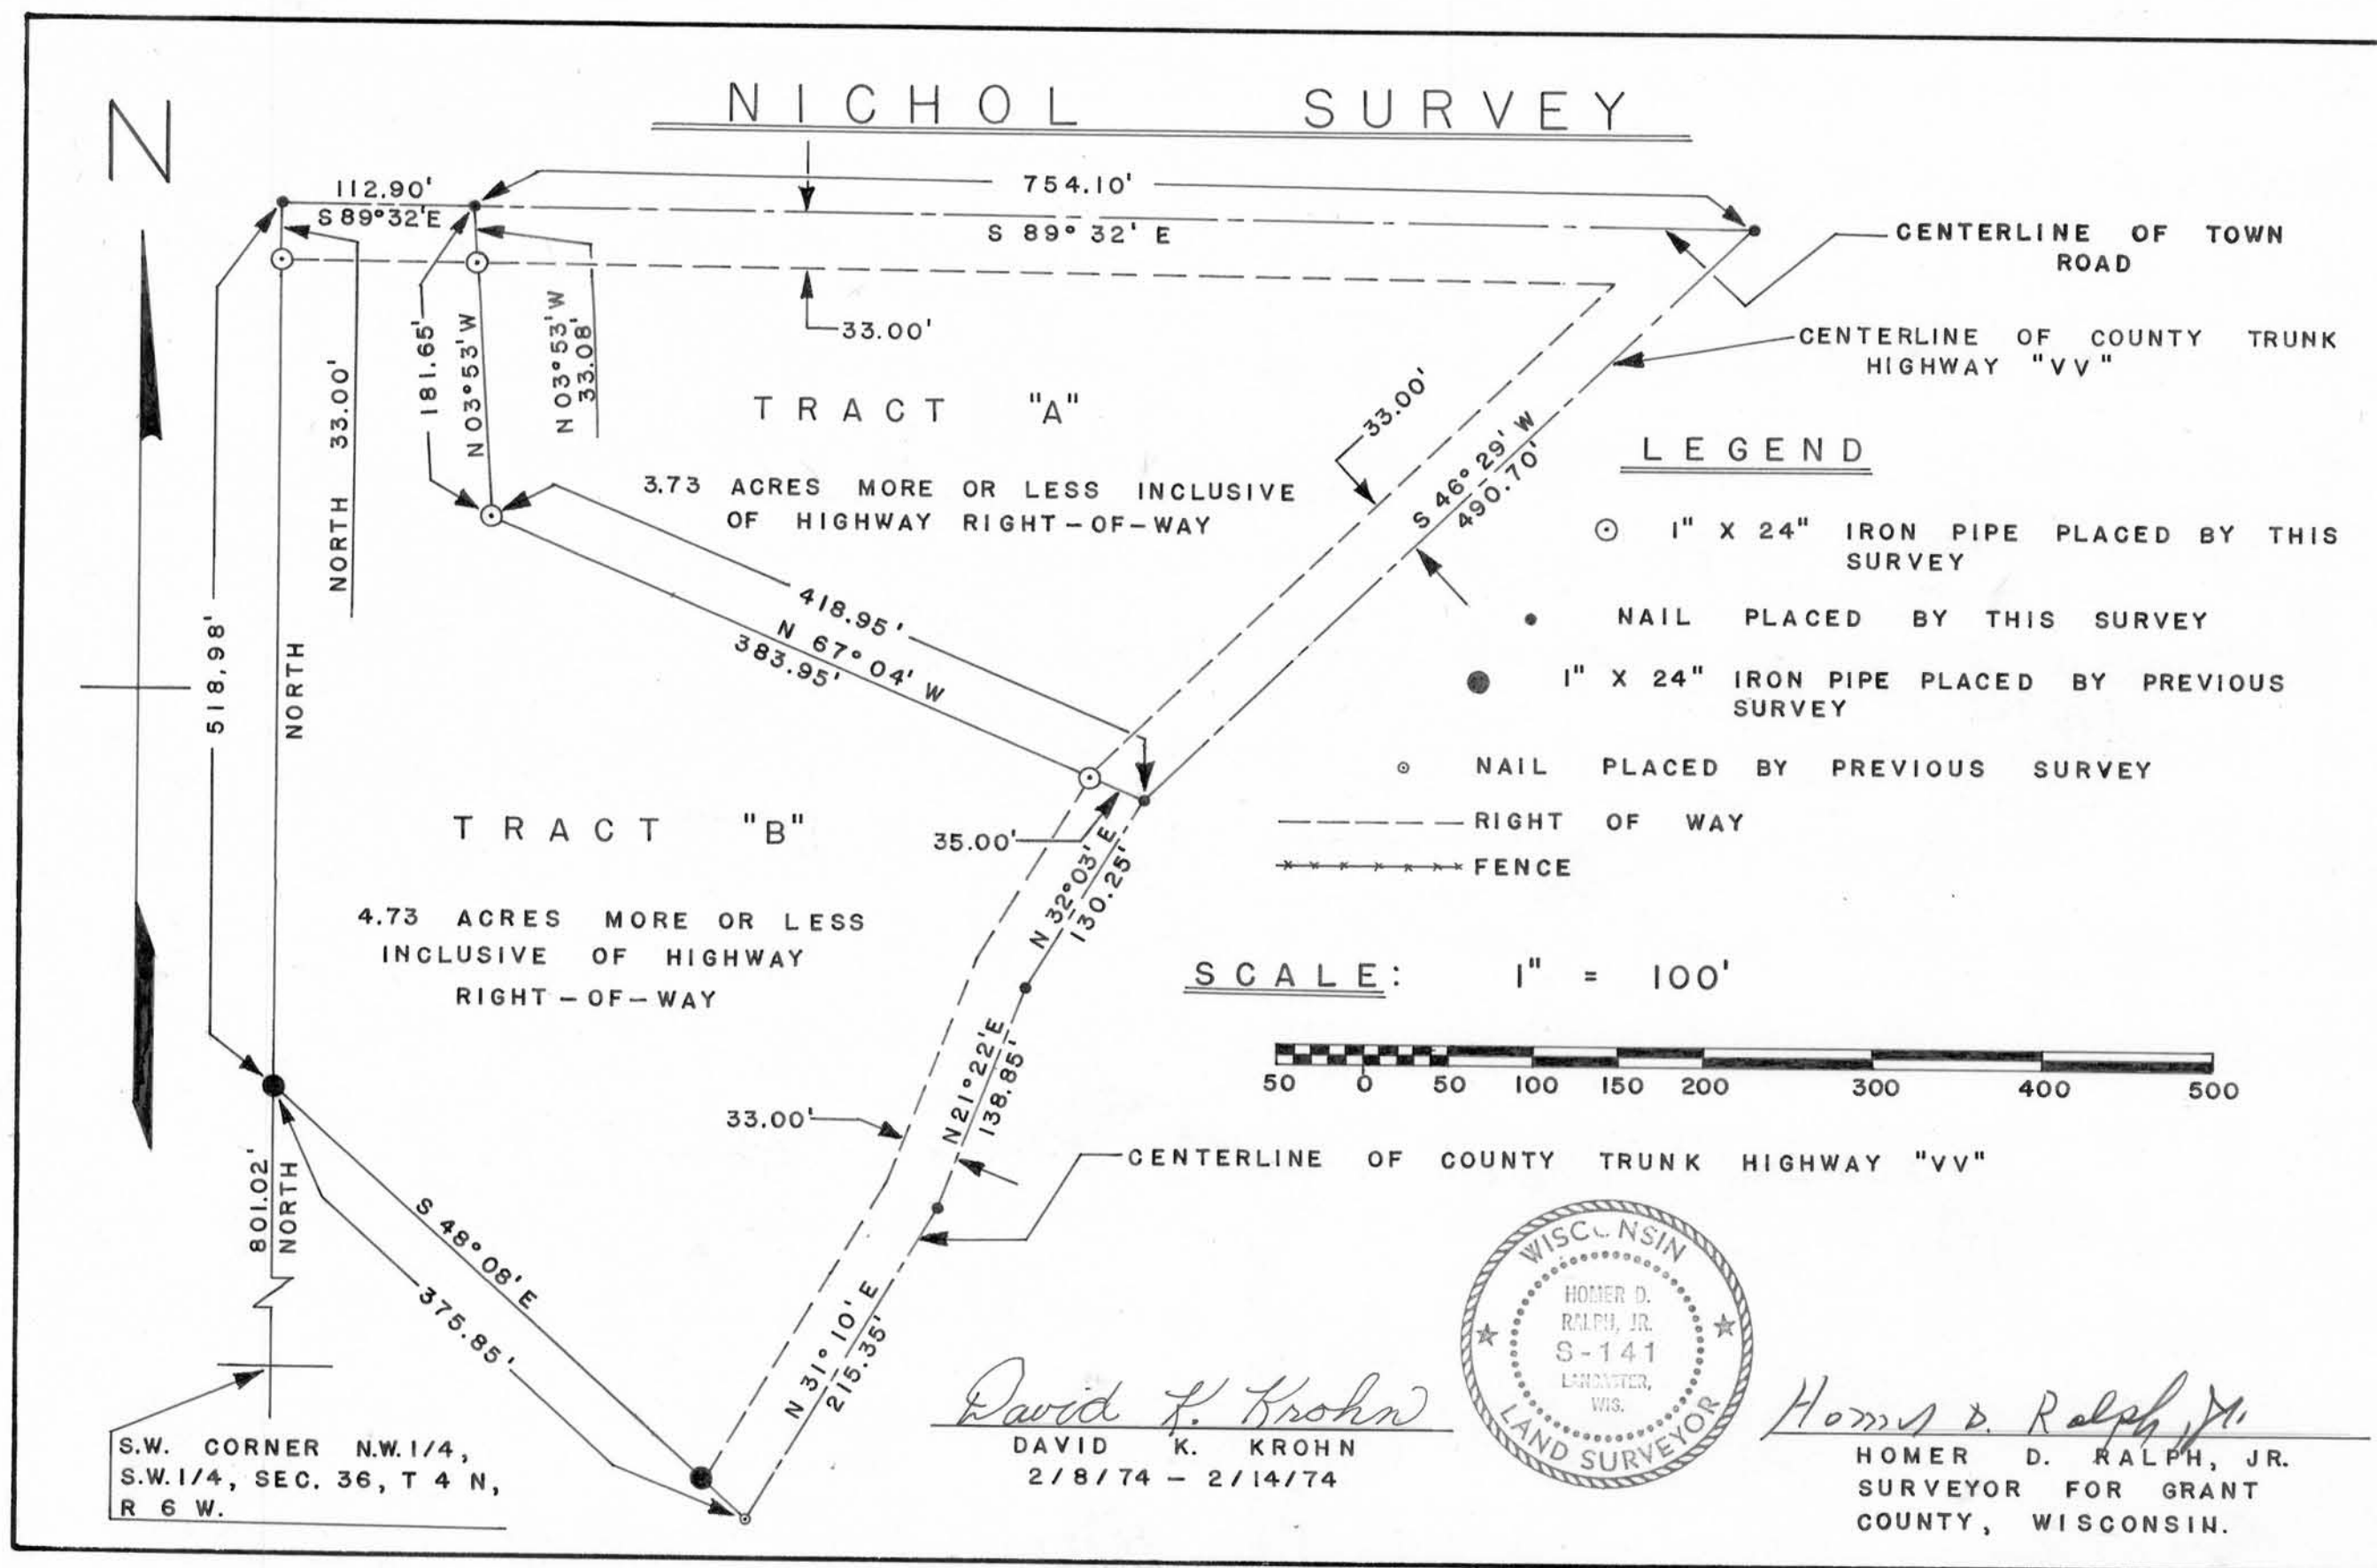

TRACT A

NICHOL DESCRIPTION

Part of the N.W.1/4 of S.W.1/4 of Section 36, T 4 N, R 6 W,
of the 4th P.M., Grant County, Wisconsin, described as follows
to-wit:

Begin at the Southwest Corner of the N.W.1/4 of S.W.1/4 of said
Section 36; thence North 1320.00 feet to the centerline of
town road; thence South 89° 32' East 112.90 feet along said
centerline to the point of beginning;

thence South 89° 32' East 754.10 feet along said town road cen-
terline to the centerline of County Trunk Highway "VV";
thence South 46° 29' West 490.70 feet along said C.T.H. center-
line; thence North 67° 04' West 418.95 feet; thence North
03° 53' West 181.65 feet to the centerline of the town road and
the point of beginning:

Containing 3.73 acres more or less inclusive of highway right-
of-way.



Homer D. Ralph, Jr.
Homer D. Ralph, Jr. RLS

TRACT B

DESCRIPTION:

Part of the N.W.1/4 of S.W.1/4 of Section 36, T 4 N, R 6 W, of the 4th P.M., Grant County, Wisconsin, described as follows to-wit:
Begin at the Southwest Corner of the N.W.1/4 of S.W.1/4 of said Section 36;
thence North 801.02 feet to the point of beginning;
thence South 48° 08' East 375.85 feet to the centerline of County Trunk Highway "VV";
thence North 31° 10' East 215.35 feet along said centerline;
thence North 21° 22' East 138.85 feet along said centerline;
thence North 32° 03' East 130.25 feet along said centerline;
thence North 67° 04' West 418.95 feet;
thence North 03° 53' West 181.65 feet to the centerline of town road;
thence North 89° 32' West 112.90 feet along said centerline;
thence South 518.98 feet to the point of beginning.
Containing 4.73 acres more or less inclusive of highway right-of-way.



Homer D. Ralph, Jr.
Homer D. Ralph, Jr. *ALS*