

PAUL JACKLEY SURVEY


DESCRIPTION:

Part of the S.W.1/4, of the S.W.1/4, of Section 16,
T 5 N, R 6 W, of the 4th P.M., Grant County, Wisconsin,
described as follows to-wit;


Begin at the Southwest Corner of said Section 16;
thence North 917.40 feet;
thence East 214.50 feet;
thence South 917.40 feet;
thence West 214.50 feet to the point of beginning.
Containing 4.52 acres more or less.

Also, part of the S.E.1/4, of the S.E.1/4, of Section 17,
T 5 N, R 6 W, of the 4th P.M., Grant County, Wisconsin,
described as follows to-wit:

Begin at the Southeast Corner of said Section 17;
thence North 203.00 feet;
thence West 140.50 feet;
thence South 39.00 feet;
thence South 40° 35' East 215.94 feet to the point of
beginning.
Containing 0.39 acres more or less.

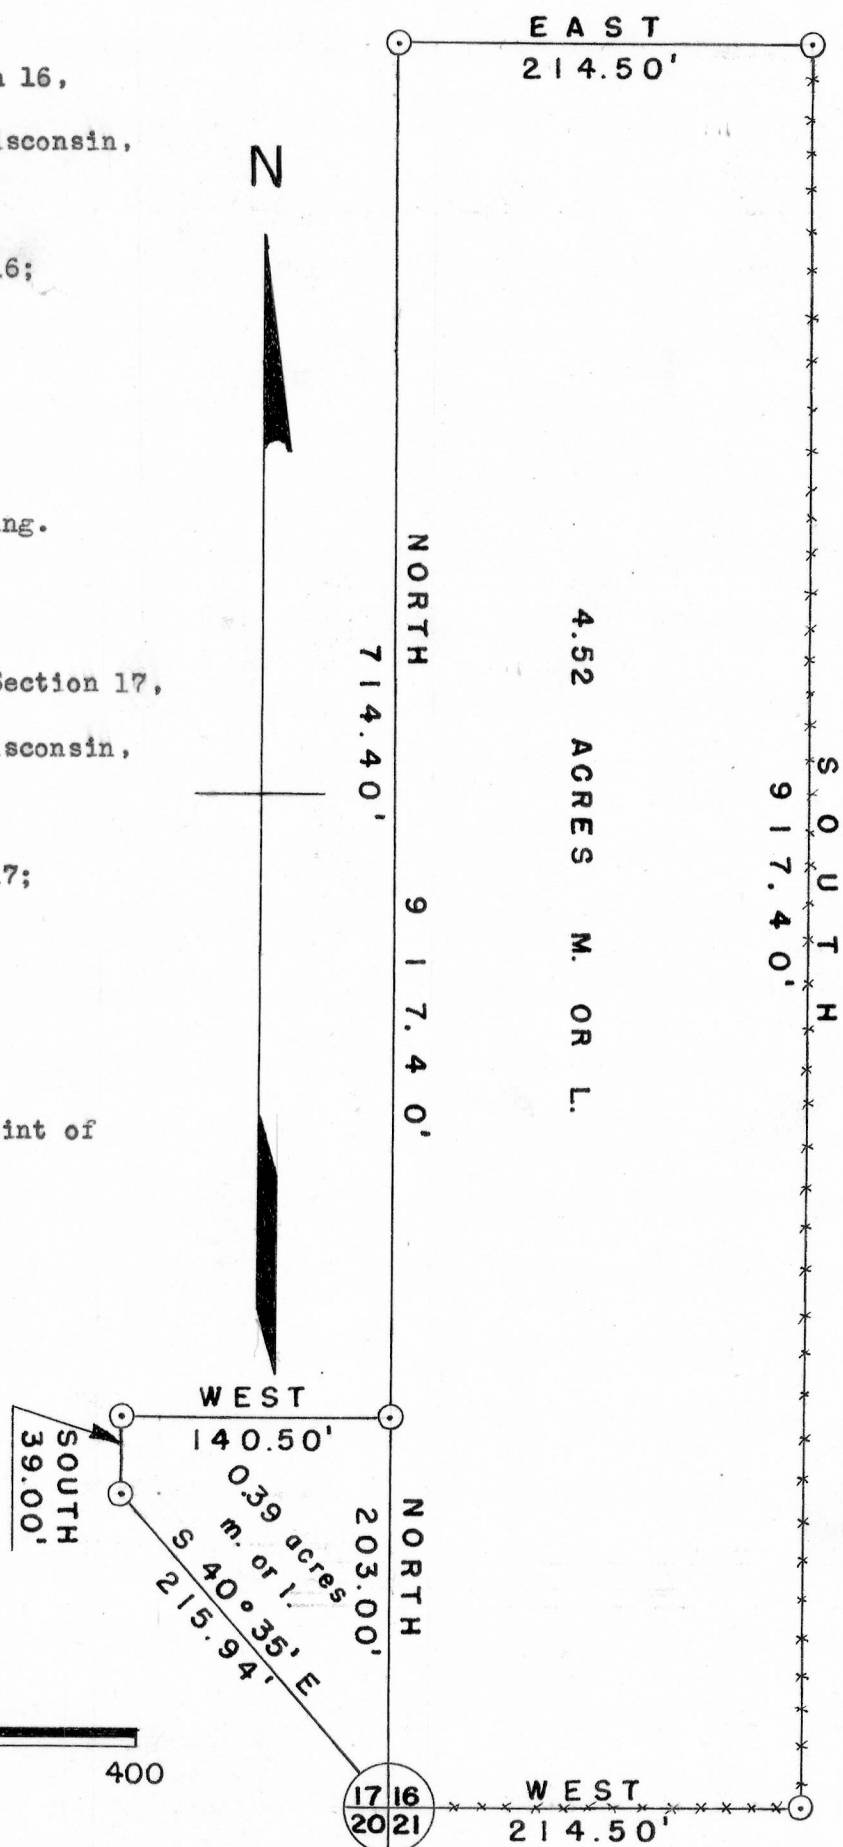


SCALE: 1" = 100'

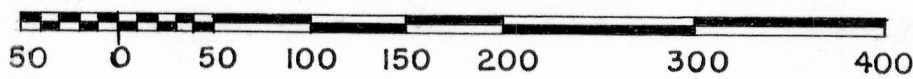

⊙ 1" X 24" IRON PIPE PLACED BY THIS SURVEY

***** FENCE

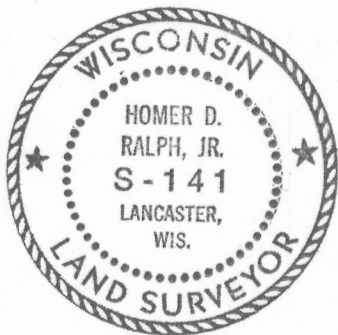

David K. Krohn
DAVID K. KROHN
10/18/73 — 10/23/73

Homer D. Ralph, Jr.
HOMER D. RALPH, JR.
SURVEYOR FOR GRANT
COUNTY, WISCONSIN.

SOUTHWEST CORNER OF
SECTION 16, T 5 N, R 6 W.
AND / OR
SOUTHEAST CORNER OF
SECTION 17, T 5 N, R 6 W.
FOUND STONE MONUMENT