



METHODIST CHURCH OF BAGLEY SURVEY

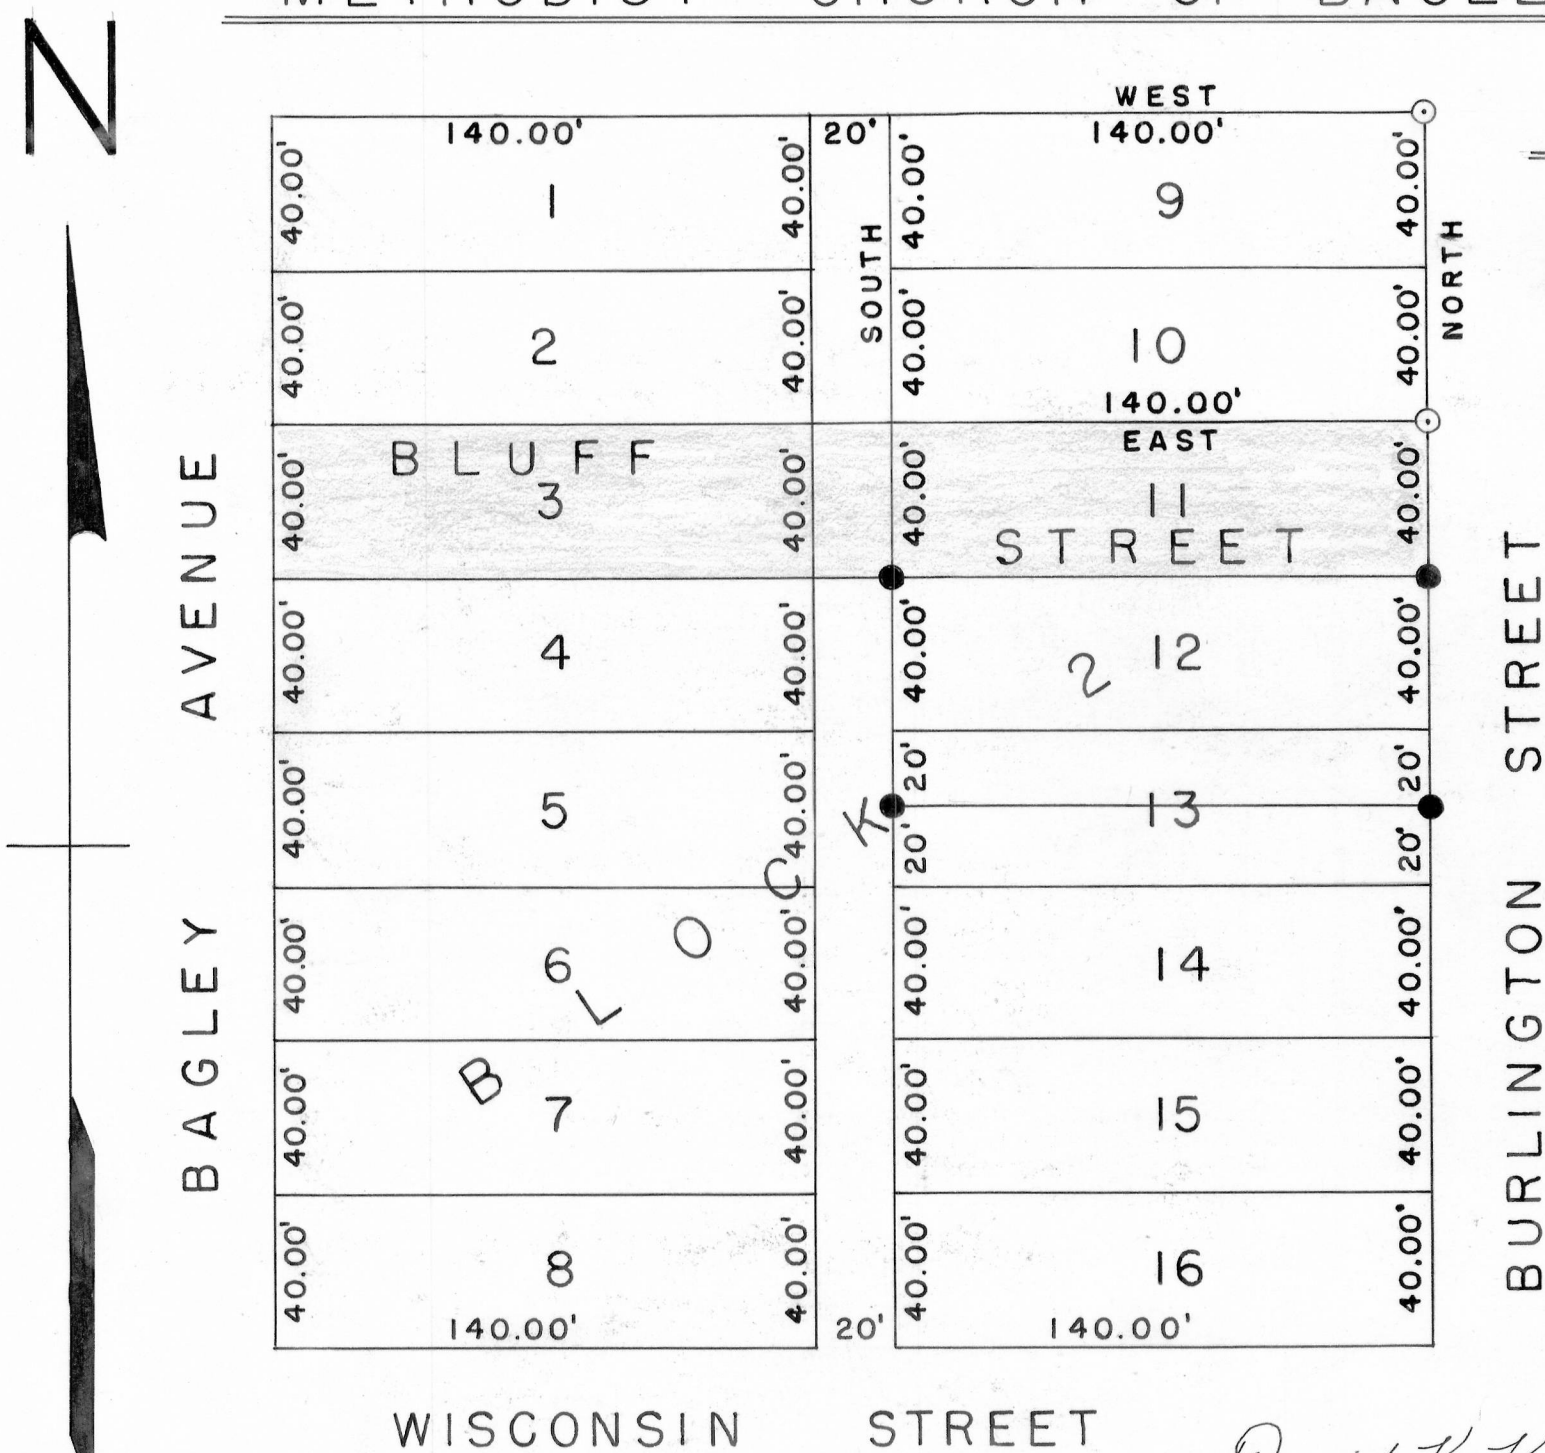

SCALE: 1" = 50'

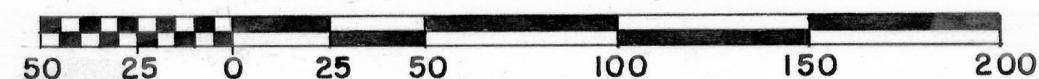


LEGEND:

- ⊙ 1" X 24" IRON PIPE PLACED BY THIS SURVEY
● 1" X 24" IRON PIPE PLACED FOR ANOTHER SURVEY

DESCRIPTION:

Lots Nine (9) and Ten (10) in Block Two (2) of the Original Plat of the Village of Bagley, Grant County, Wisconsin, according to the recorded map or plat thereof.

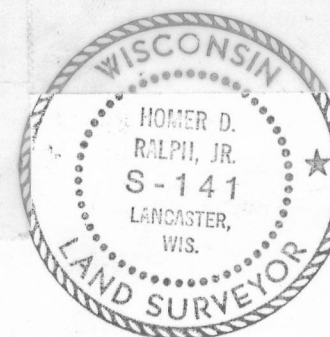

David K. Krohn
DAVID K. KROHN
10/10/74 - 10/11/74

HOMER D. RALPH, JR.
SURVEYOR FOR GRANT
COUNTY, WISCONSIN.