


WILFORD KNIGHT SURVEY



SCALE: 1" = 50'

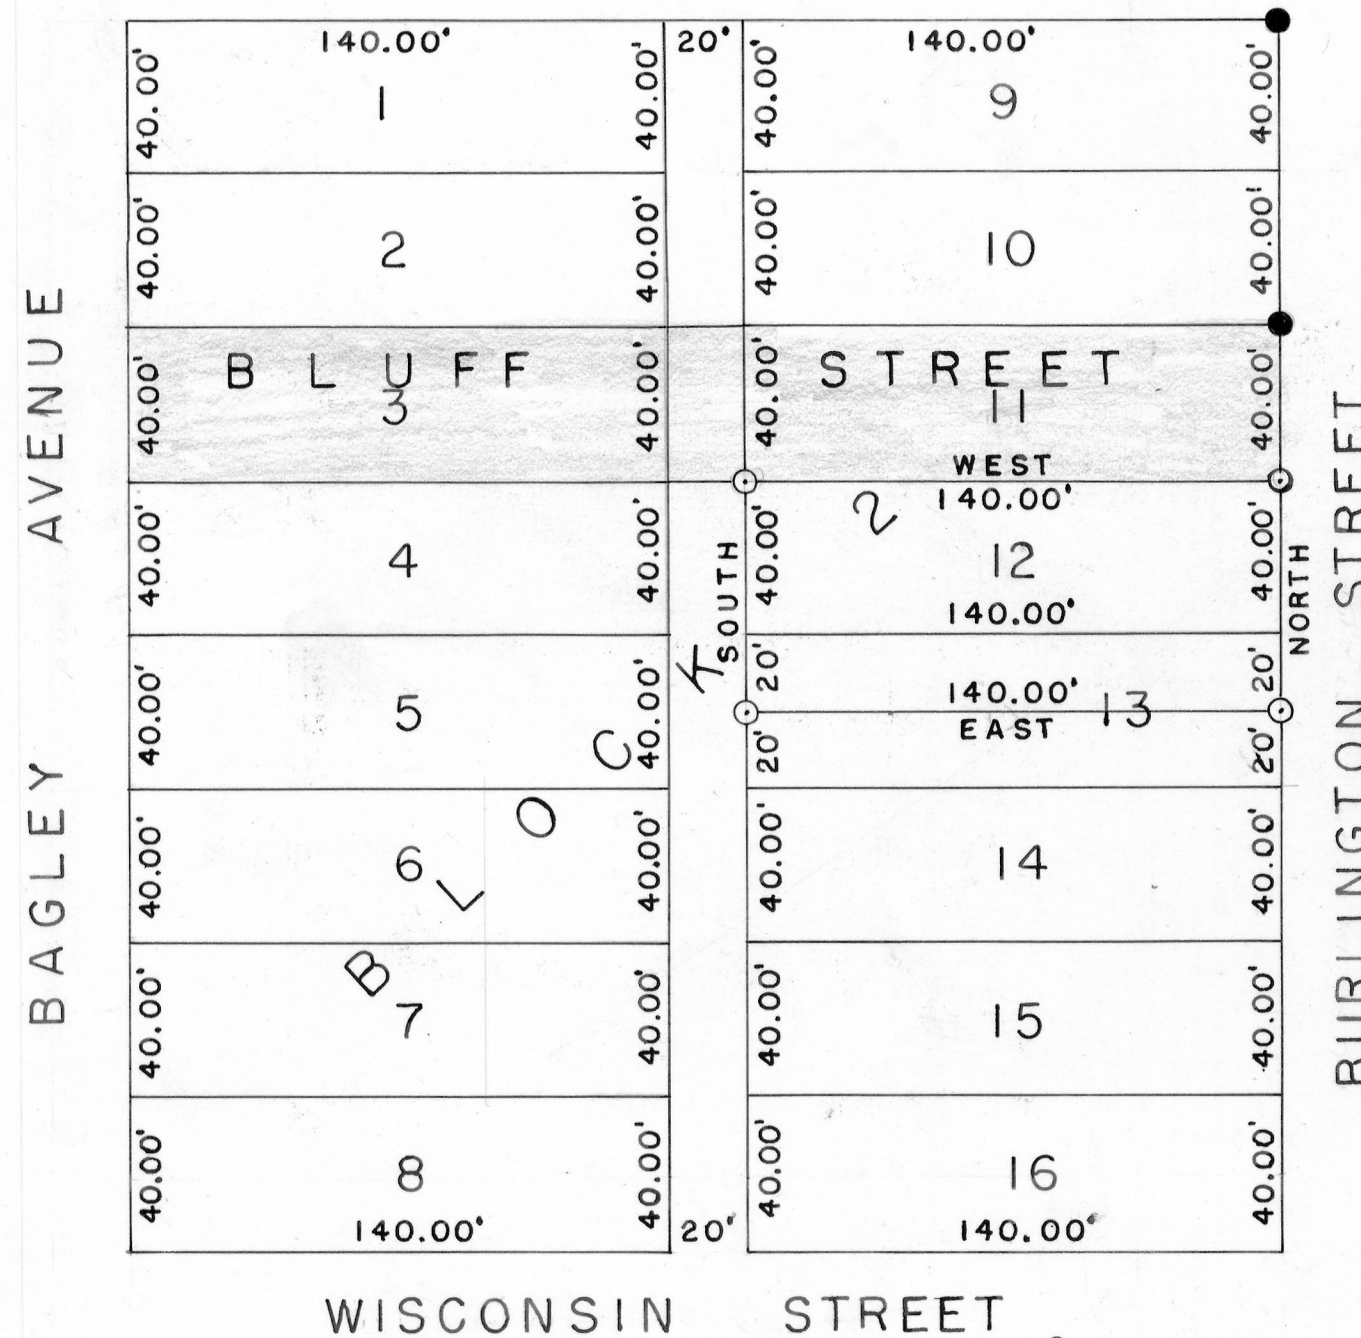


LEGEND:

- 1" X 24" IRON PIPE PLACED BY THIS SURVEY
- 1" X 24" IRON PIPE PLACED BY PREVIOUS SURVEY

DESCRIPTION:

Lot Twelve (12) and the North Half (1/2) of Lot
Thirteen (13) in Block Two (2) of the Original Plat
of the Village of Bagley, Grant County, Wisconsin,
according to the recorded map or plat thereof.

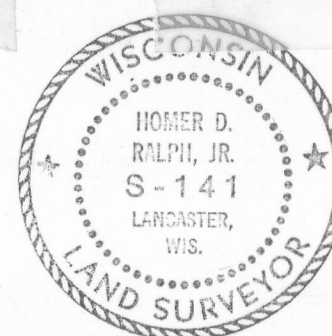

David K. Krohn
DAVID K. KROHN
10/10/74-10/11/74

HOMER D. RALPH, JR.
SURVEYOR FOR GRANT
COUNTY, WISCONSIN.