


DOWNIE SURVEY

SCALE 1" = 50'

○ 1" x 24" PIPE PLACED BY FORMER SURVEY

▲ 1" ANGLE IRON PLACED BY THIS SURVEY

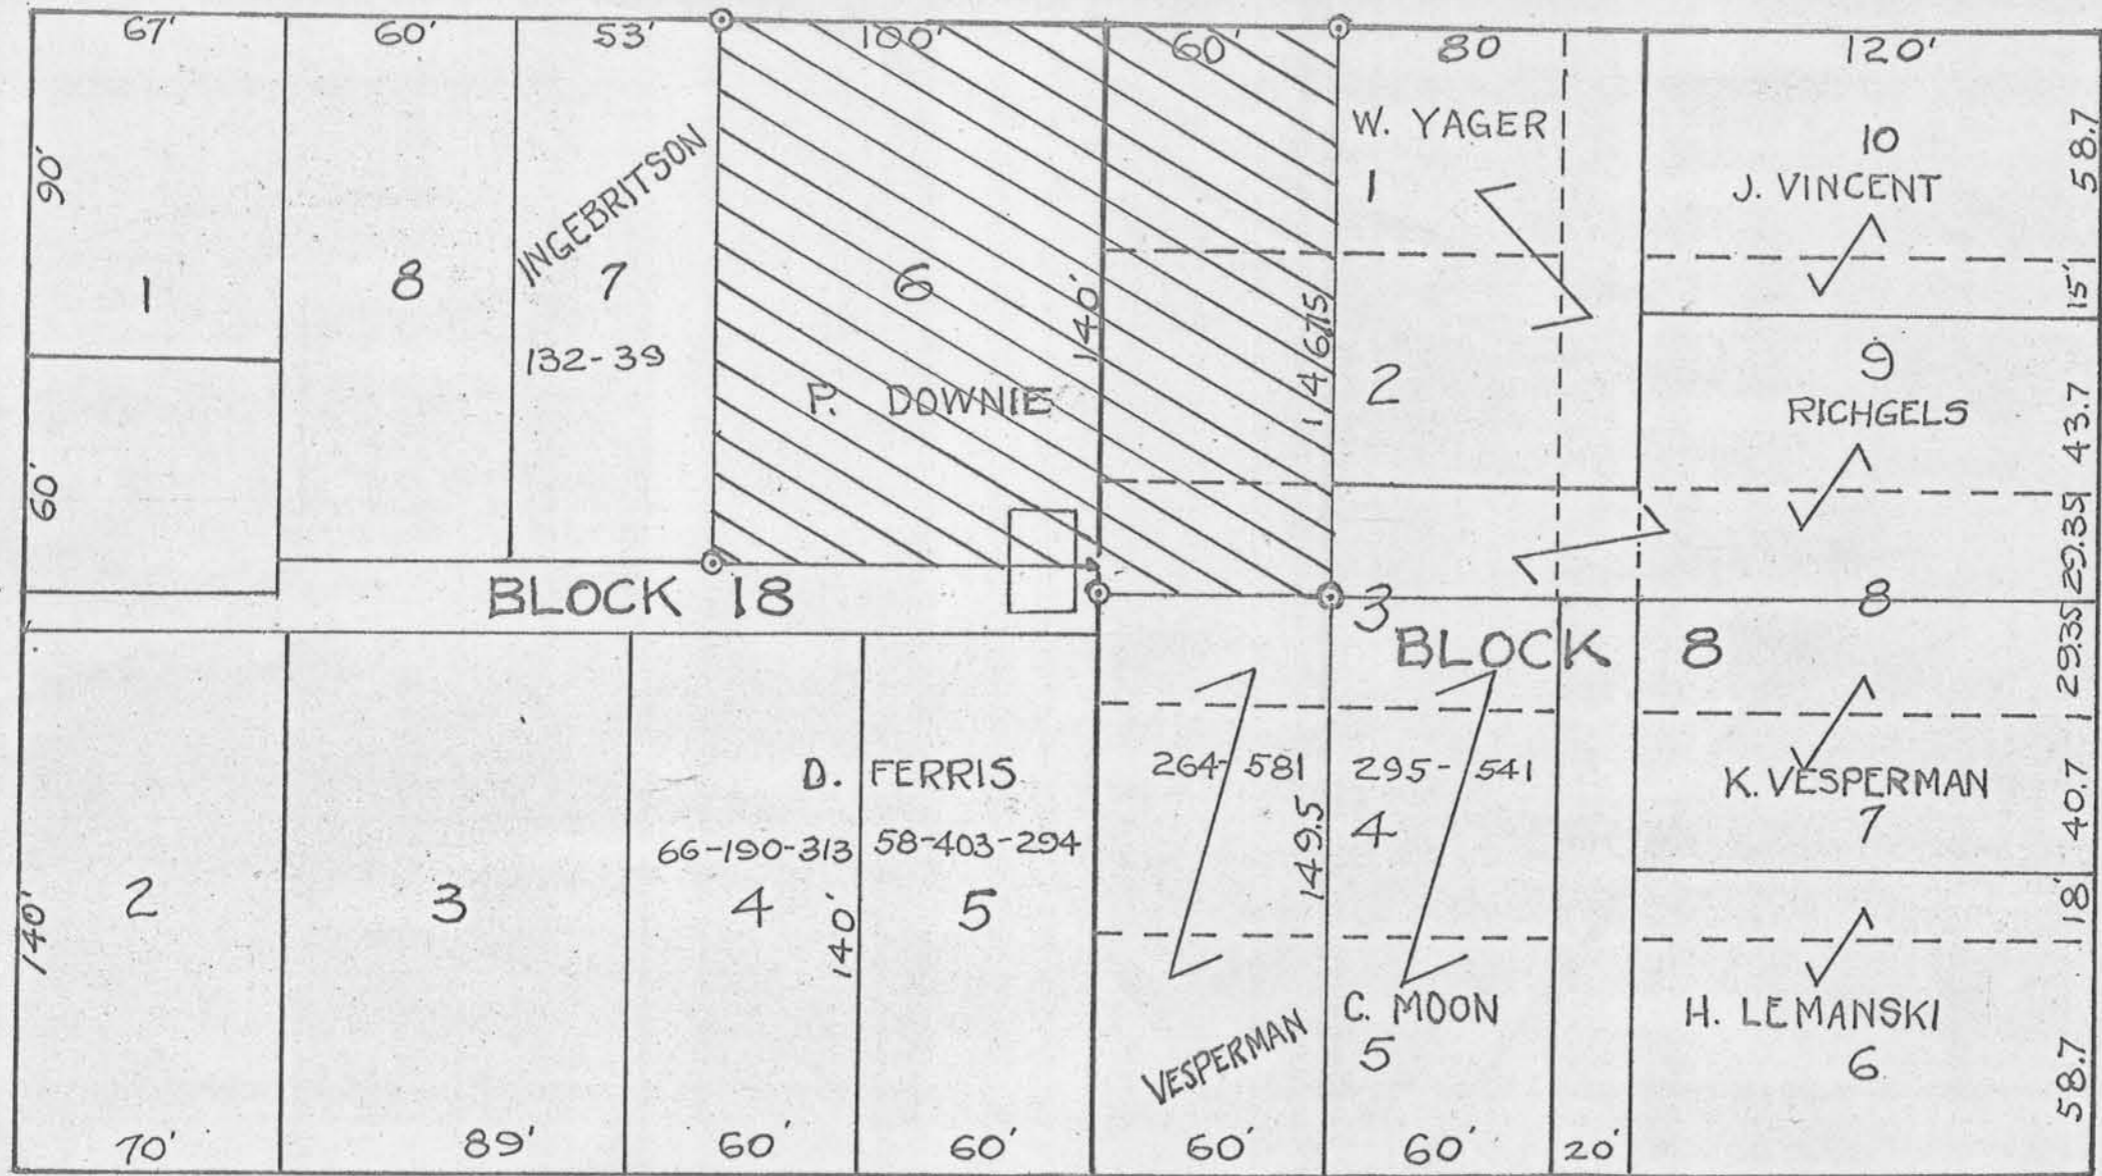

Frank Holmes
Frank Holmes



Homer D. Ralph, Jr.
Homer D. Ralph, Jr.
Surveyor For Grant Co., Wis.
Wis. Reg. No. S-141